


T. 40S., R.13W., W.M.

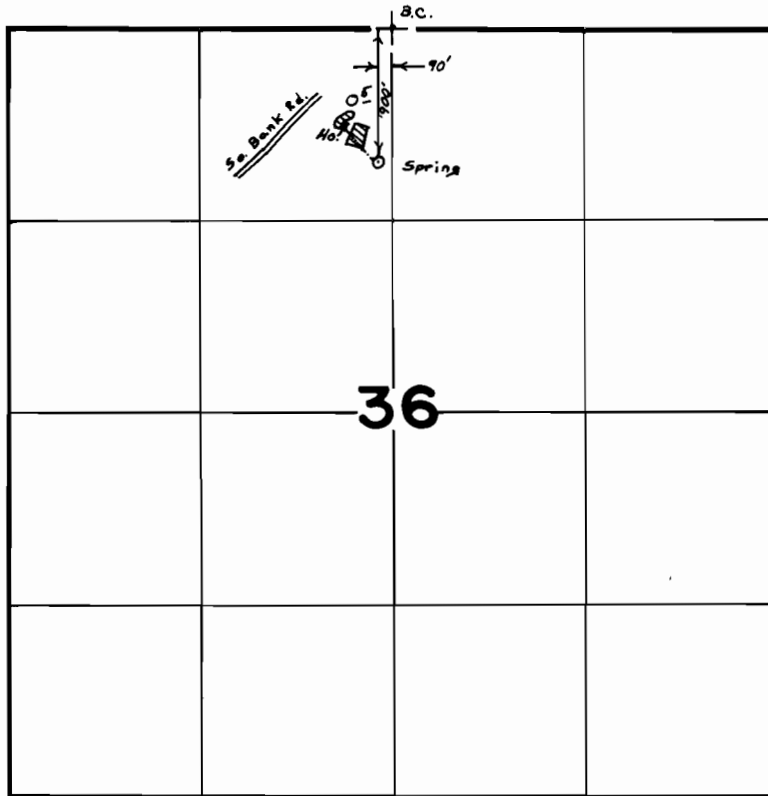

SCALE 4"=1 mile

FINAL PROOF SURVEY
UNDER

Application No. 50010... Permit No. 36737...
IN NAME OF

.....NICK M. & THELMA CARUSO.....

Surveyed August 14, 1979, by S. Donaldson...