


T.38S., R.3W., W.M.

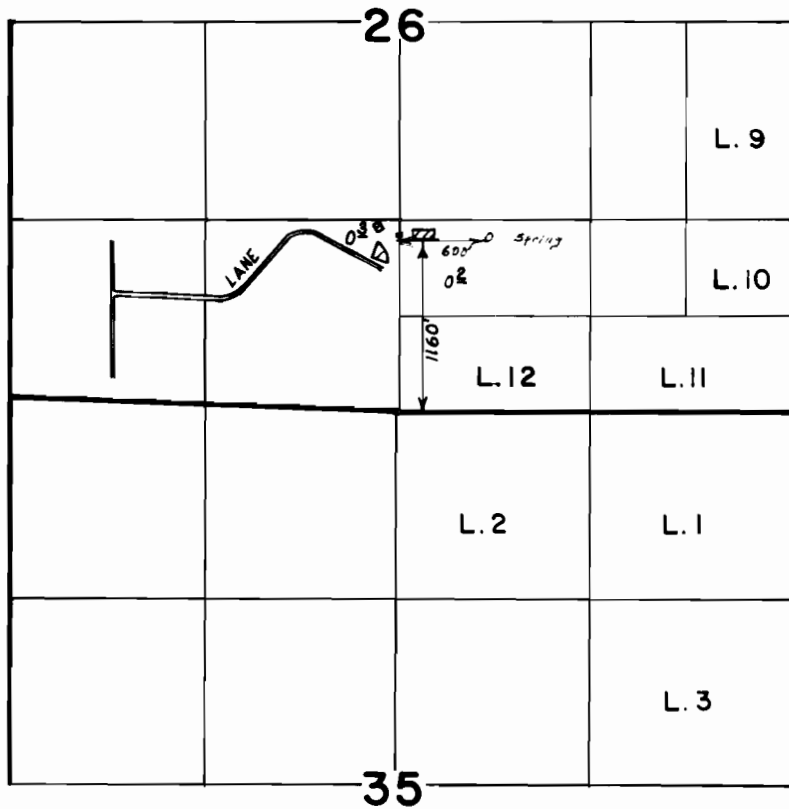

SCALE: 1" = 1320'

FINAL PROOF SURVEY UNDER

Application No. 49957 Permit No. 37583
IN NAME OF

V. M. KITCHEN

Surveyed APRIL 20 1982, by BRUCE R. SUND