




T.1N. R.19 & 20E. WM.

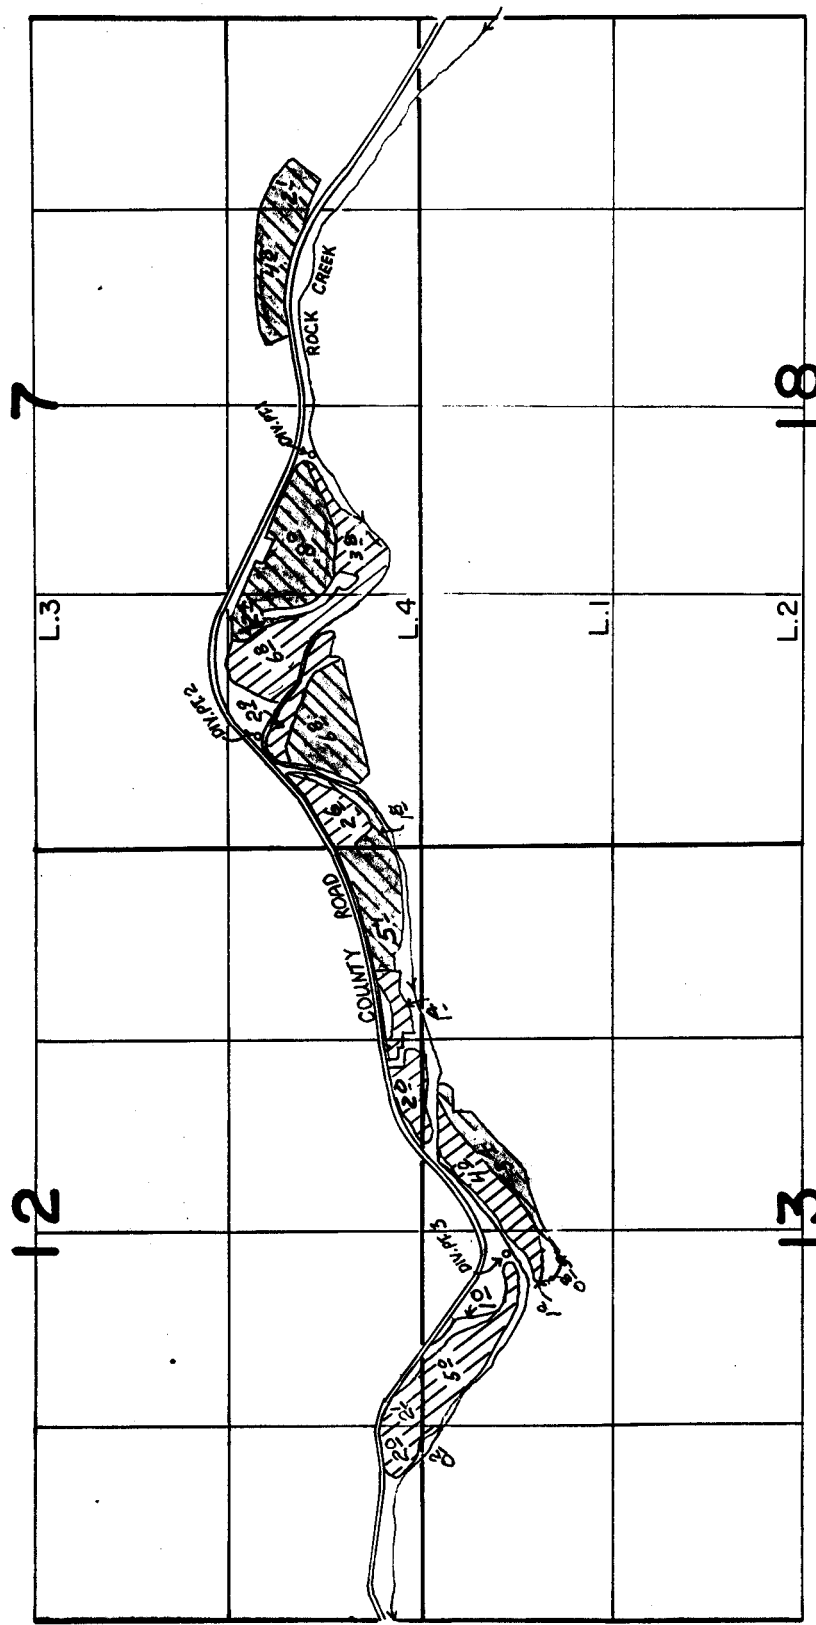

DIV. PT. 1 LOCATED 740' N. AND 2700' E. FROM SW. COR. SEC. 7
 DIV. PT. 2 LOCATED 1120' N. AND 770' E. FROM SW. COR. SEC. 7
 DIV. PT. 3 LOCATED 580' S. AND 2790' W. FROM SW. COR. SEC. 7

-  PRIMARY, PER. 38739
 PER. 40704, WINTER RIGHT
 SUPPL. TO PER. 38739
-  PRIMARY, CERT. 2830
 PER. 40704, WINTER RIGHT
 SUPPL. TO CERT 2830

FINAL PROOF SURVEY
 UNDER

51308 38739
 Application No. 53929 Permit No. 40704
 IN NAME OF

CHARLES T. & EDITH L. WELP

Surveyed May 21 1985, By V.L. CHURCH

P-38739
 56572
 57667