


P-48084
C-56576

T. 17S., R. 28E., W. M.

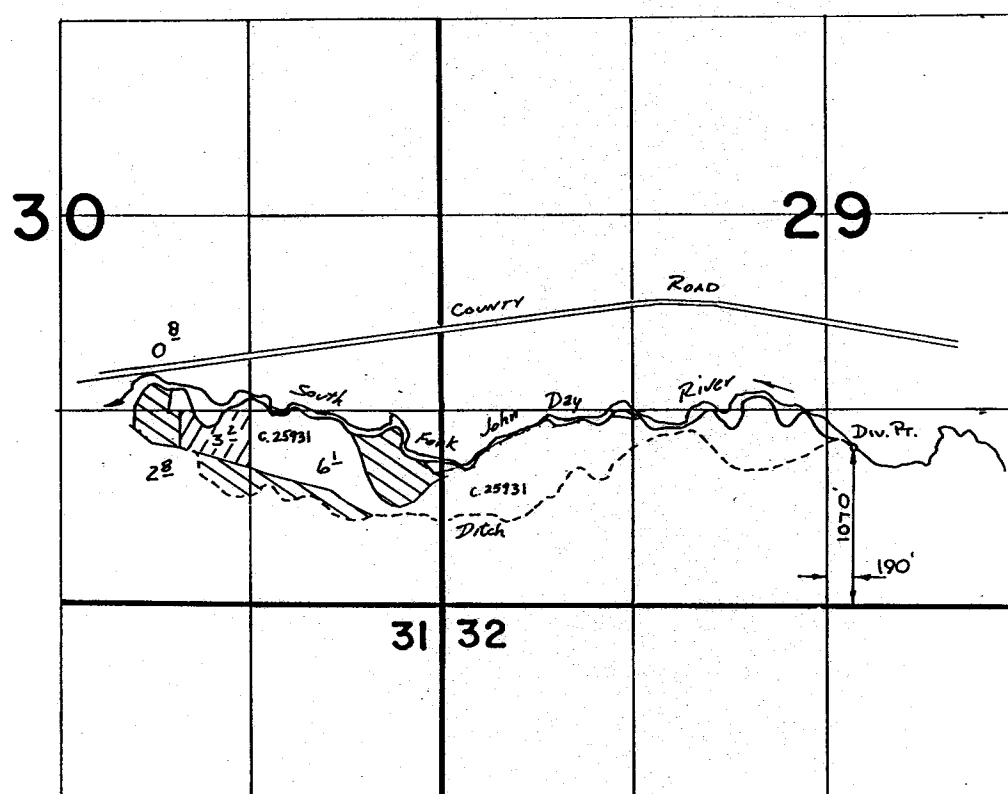

SCALE 1"=1320'

FINAL PROOF SURVEY
UNDER

39405

29369

Application No. 66600 Permit No. 48084
IN NAME OF

CHARLES J. & MIRIAM J. ST. CLAIR

Surveyed 4-23-1986, by L. TOLL

