


T. 12S., R. 34E., W.M.

SCALE 1"=1320'

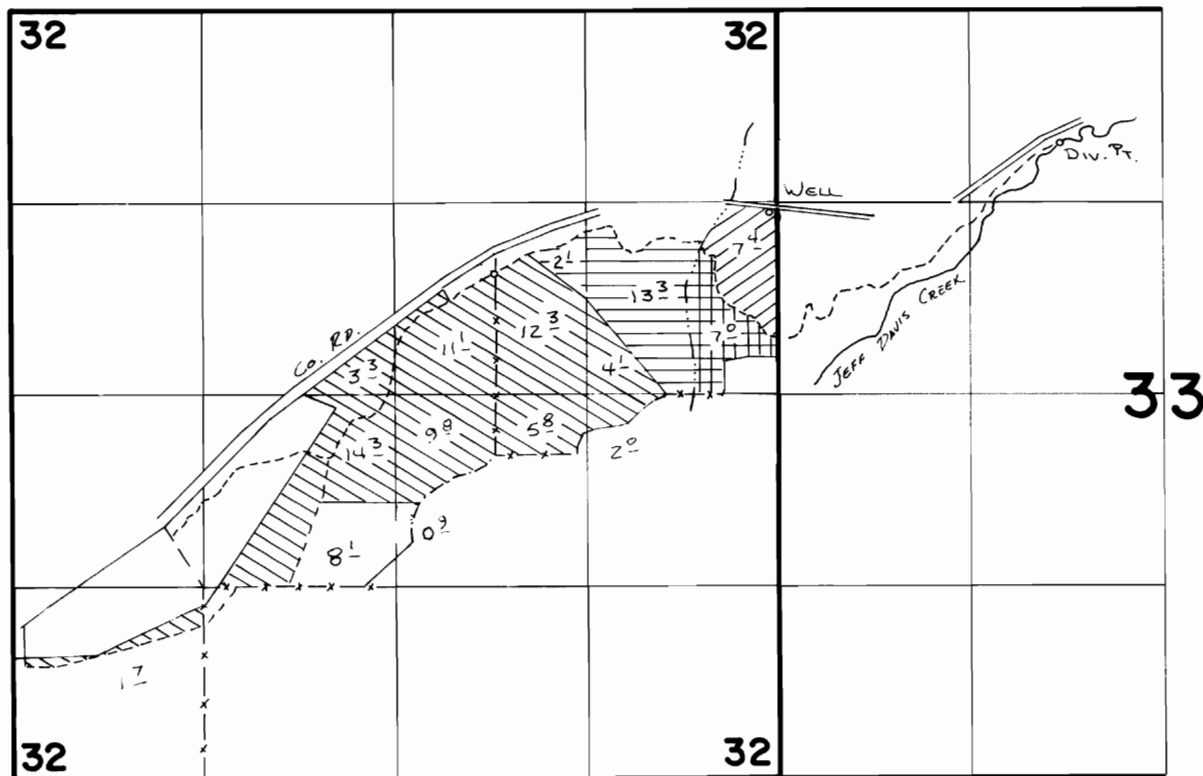

Div. Pt. Loc: 910'S. & 1940'E }
WELL Loc: 1390'S. & 50'W. } FROM NE COR SEC 32

FINAL PROOF SURVEY UNDER

TRANSFER 3931

Application No. 53711 Permit No. 40104
G-7136 G-6586
IN NAME OF

DOROTHY BLASING

Surveyed 3-18-1986, by L. TALL

-  PRIM PER. 40104
-  T- 3931
-  PRIM PER. G-6586
-  SUPPL PER. G-6586