


T. 2S., R. 1W., W.M.

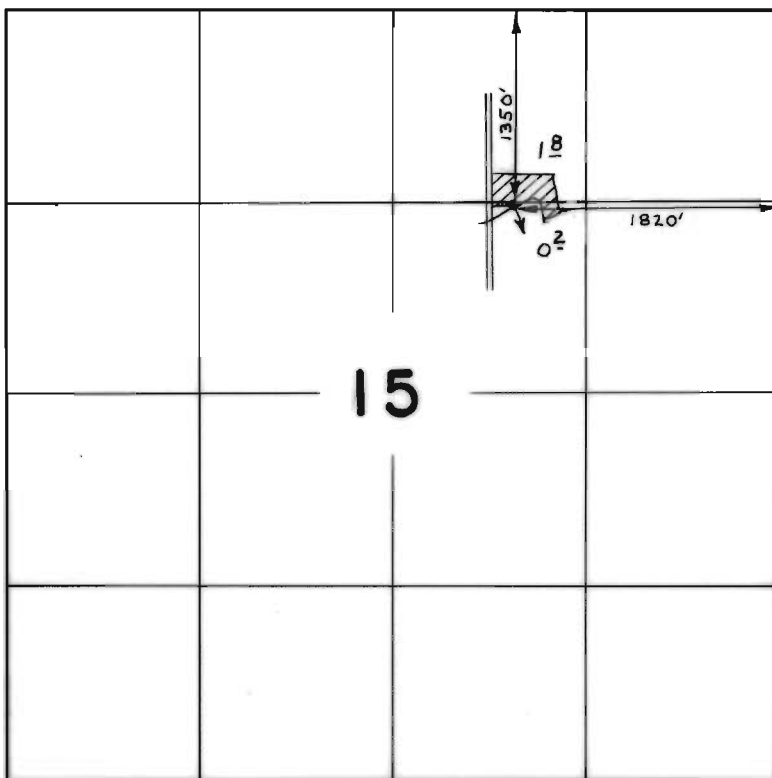

SCALE: 1" = 1320'

FINAL PROOF SURVEY
UNDER

Application No. 50938 Permit No. 40282
IN NAME OF

LEON NORVAL STEEL

Surveyed NOV 9 1983, by L. TOLL