


T. 33 S., R. 6 & 7 W., W.M.

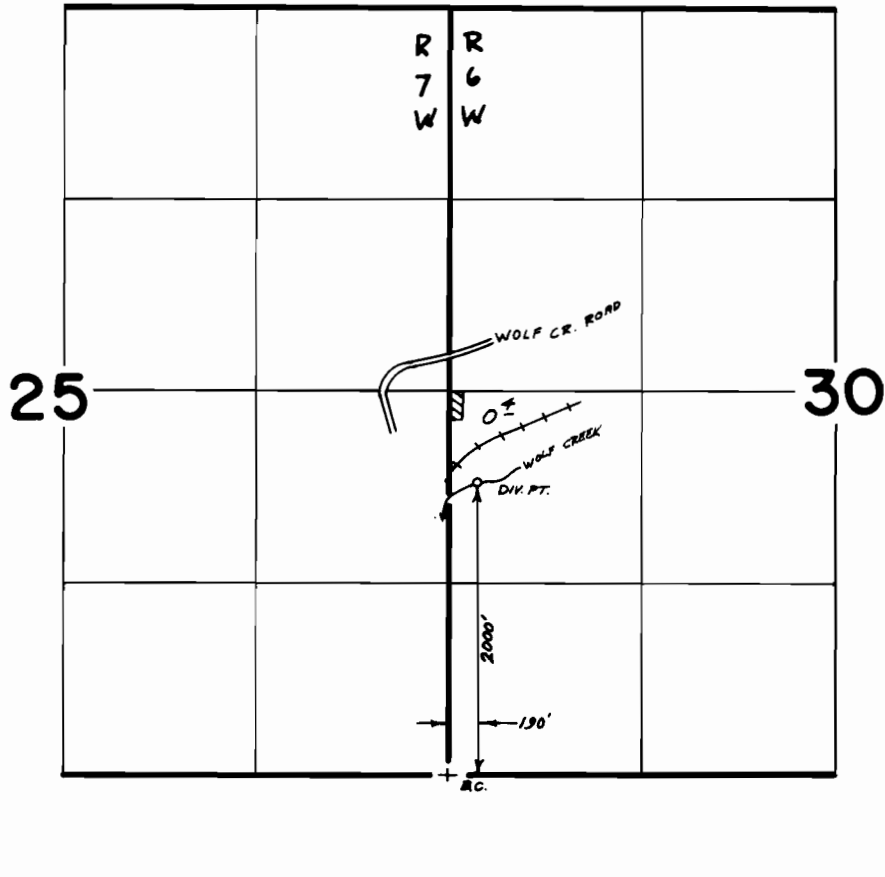

Scale 1" = 1320'

**FINAL PROOF SURVEY**  
UNDER

Application No. 53752.. Permit No. 40367.....  
IN NAME OF

.....STEPHEN POREDA.....

Surveyed AUG. 22. 1984, by J.R. WOODROOF