


Application No. 67977
 Permit No. 48227

30 29
 31 32

29 28
 32 33

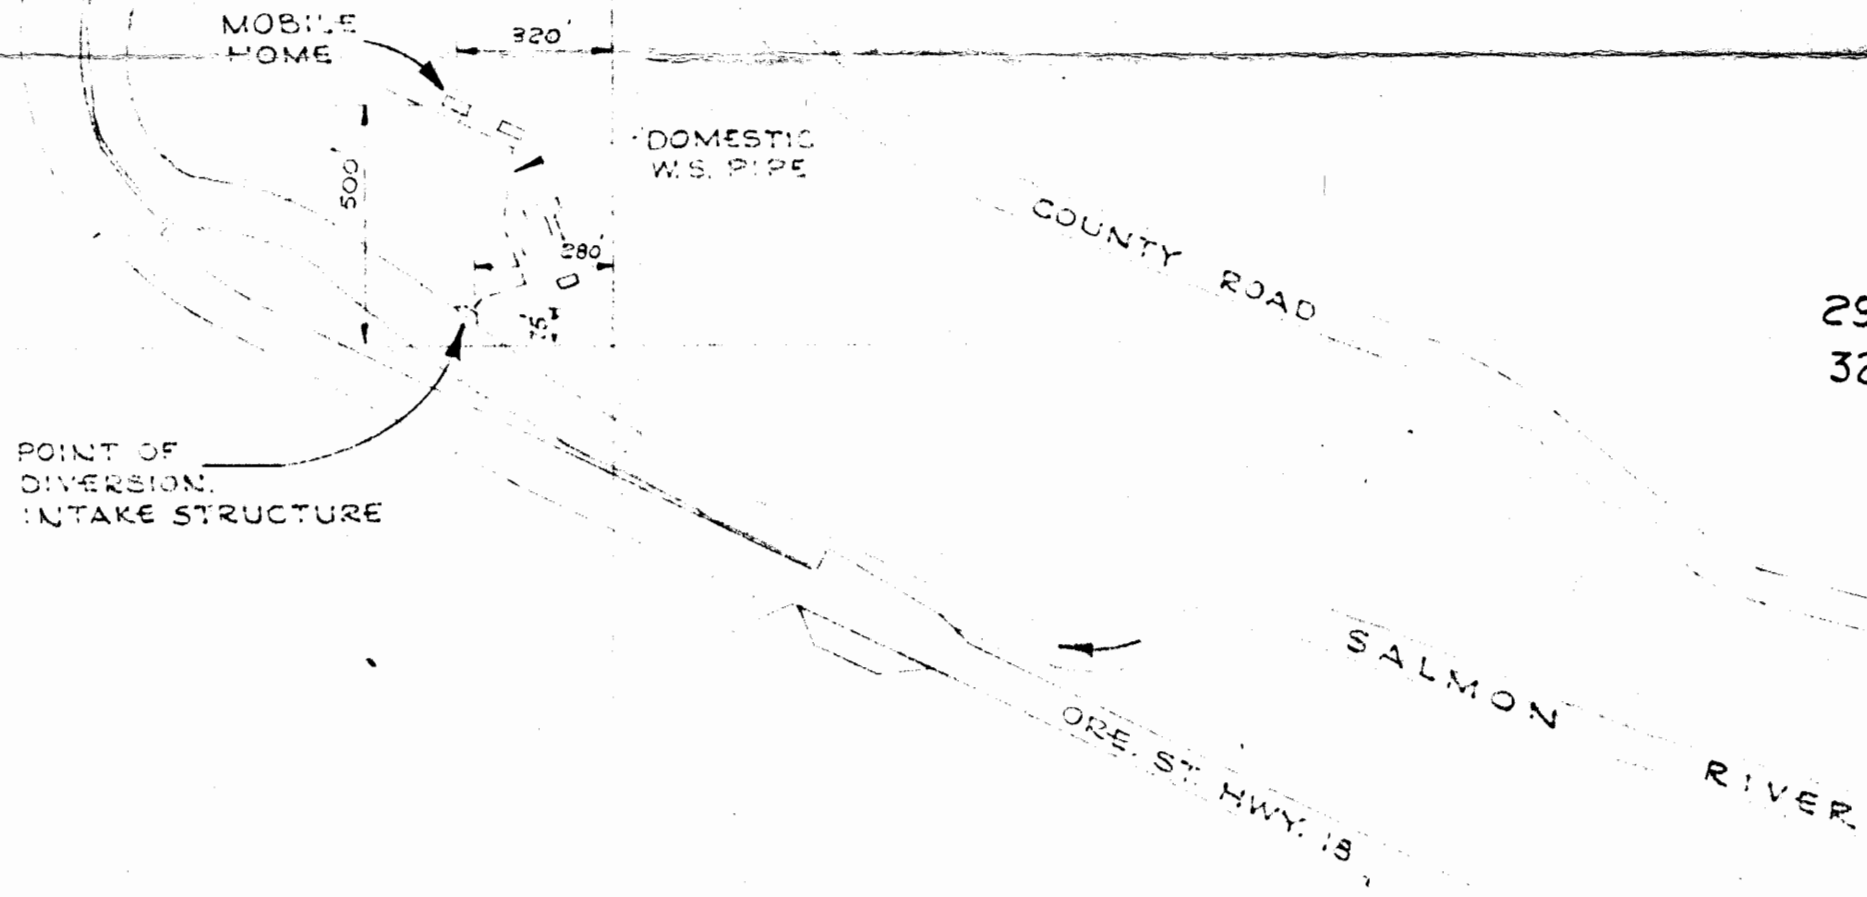

RECEIVED
 NOV 29 1983
 WATER RESOURCES DEPT.
 SALEM, OREGON

APPLICATION NO.
 PERMIT NO.

		DEPARTMENT OF FISH & WILDLIFE	
		STATE OF OREGON	
		SALMON RIVER FISH HATCHERY	
		WATER RIGHTS MAP	
		T65, R10W	
		LINCOLN COUNTY	
		1" = 400'	
REVISIONS	CHIEF ENGINEER	APP'VD _____ DIRECTOR	
	DATE NOV. 10, 1983	FILE NO.	SHT. OF
	DESIGN BY		
	DRAWN BY ROD		
	CHECKED BY		