


T. 26 S., R. 4 W., W.M.

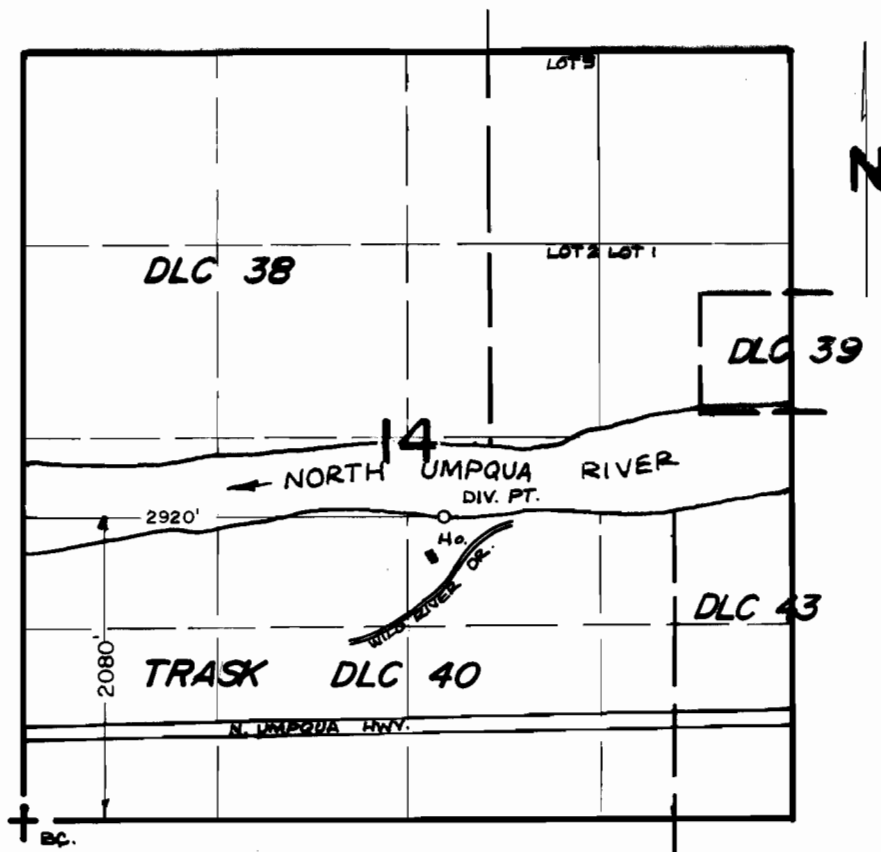

SCALE: 4" = 1 MILE

FINAL PROOF SURVEY UNDER

Application No. ..68235.. Permit No.49027.....
IN NAME OF

..PAUL W... & STACIE L... NELSON.....

Surveyed ..SEPT..3, 19.86., by ..J.M..SCHMORDE..