




T. 2 S., R. 2 E., W.M.

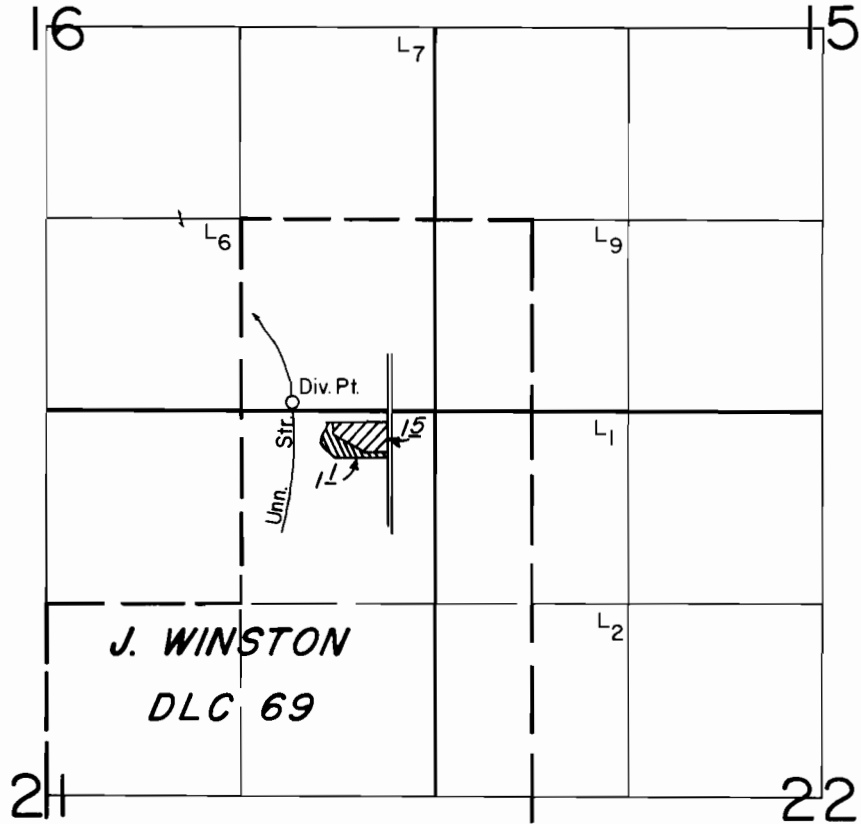

DIV. PT. LOC: 1270' S. & 1650' W. FROM NE. CORNER J. WINSTON DLC. 69

SCALE: 1" = 1320'

FINAL PROOF SURVEY UNDER

Application No. 62034 Permit No. 46313
55127 41335
 IN NAME OF



..... NORMAN BEYL

Surveyed AUG. 22 1986, by T. WARREN.....