



T. 33 S., R. 2 E., W. M.

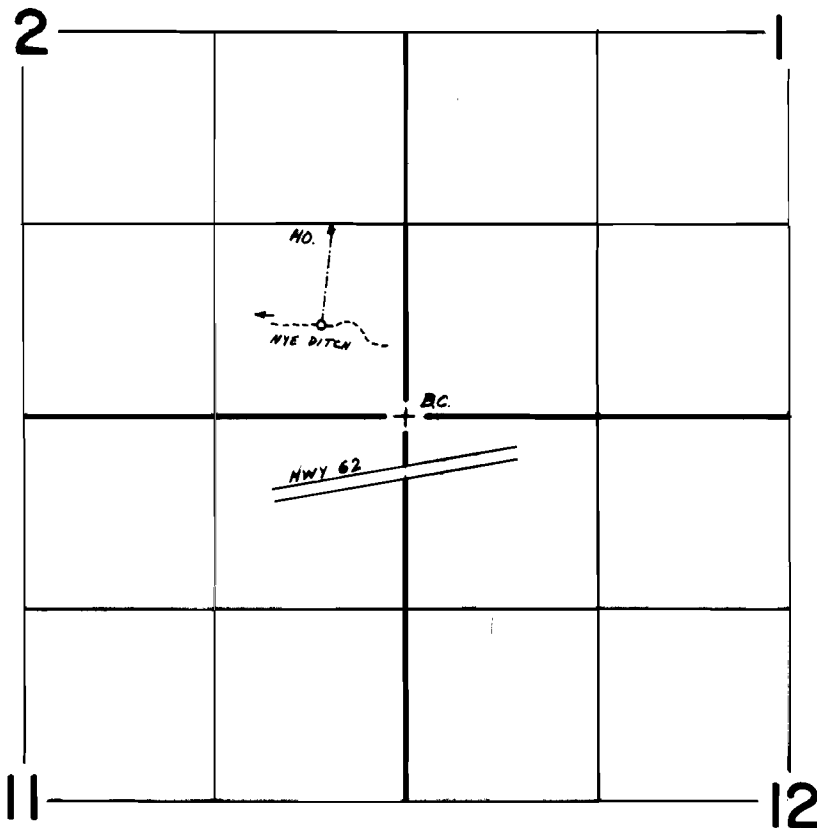

T. 32 S., R. 3 E., W. M.

SCALE 1"=1320'

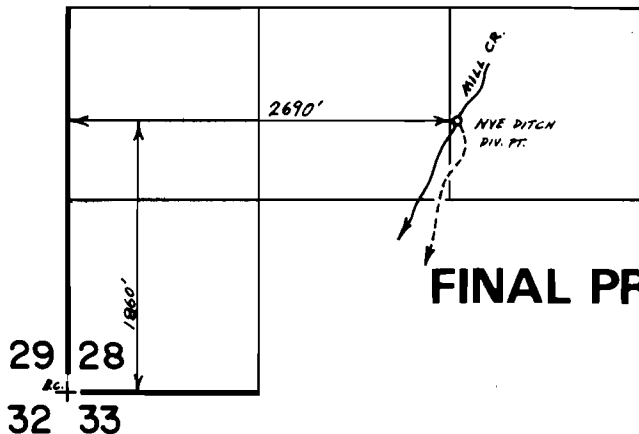

FINAL PROOF SURVEY
UNDER

Application No. 55928 Permit No. 42045...
IN NAME OF

.....PATRICK OROPALLO.....

Surveyed May 23, 1983, by B.S. JAMES.....

New owner Mitch Lee