


SECTION 13 T.2S. R.1E. W.M.  
CLACKAMAS COUNTY

D. L. C.  
B. B. ROGERS  
B. JENNINGS  
JESSE BULLOCK  
STEPHEN WALKER  
GEORGE WALLING  
GABRIEL WALLING

56232  
Form No 42107

1"=400'

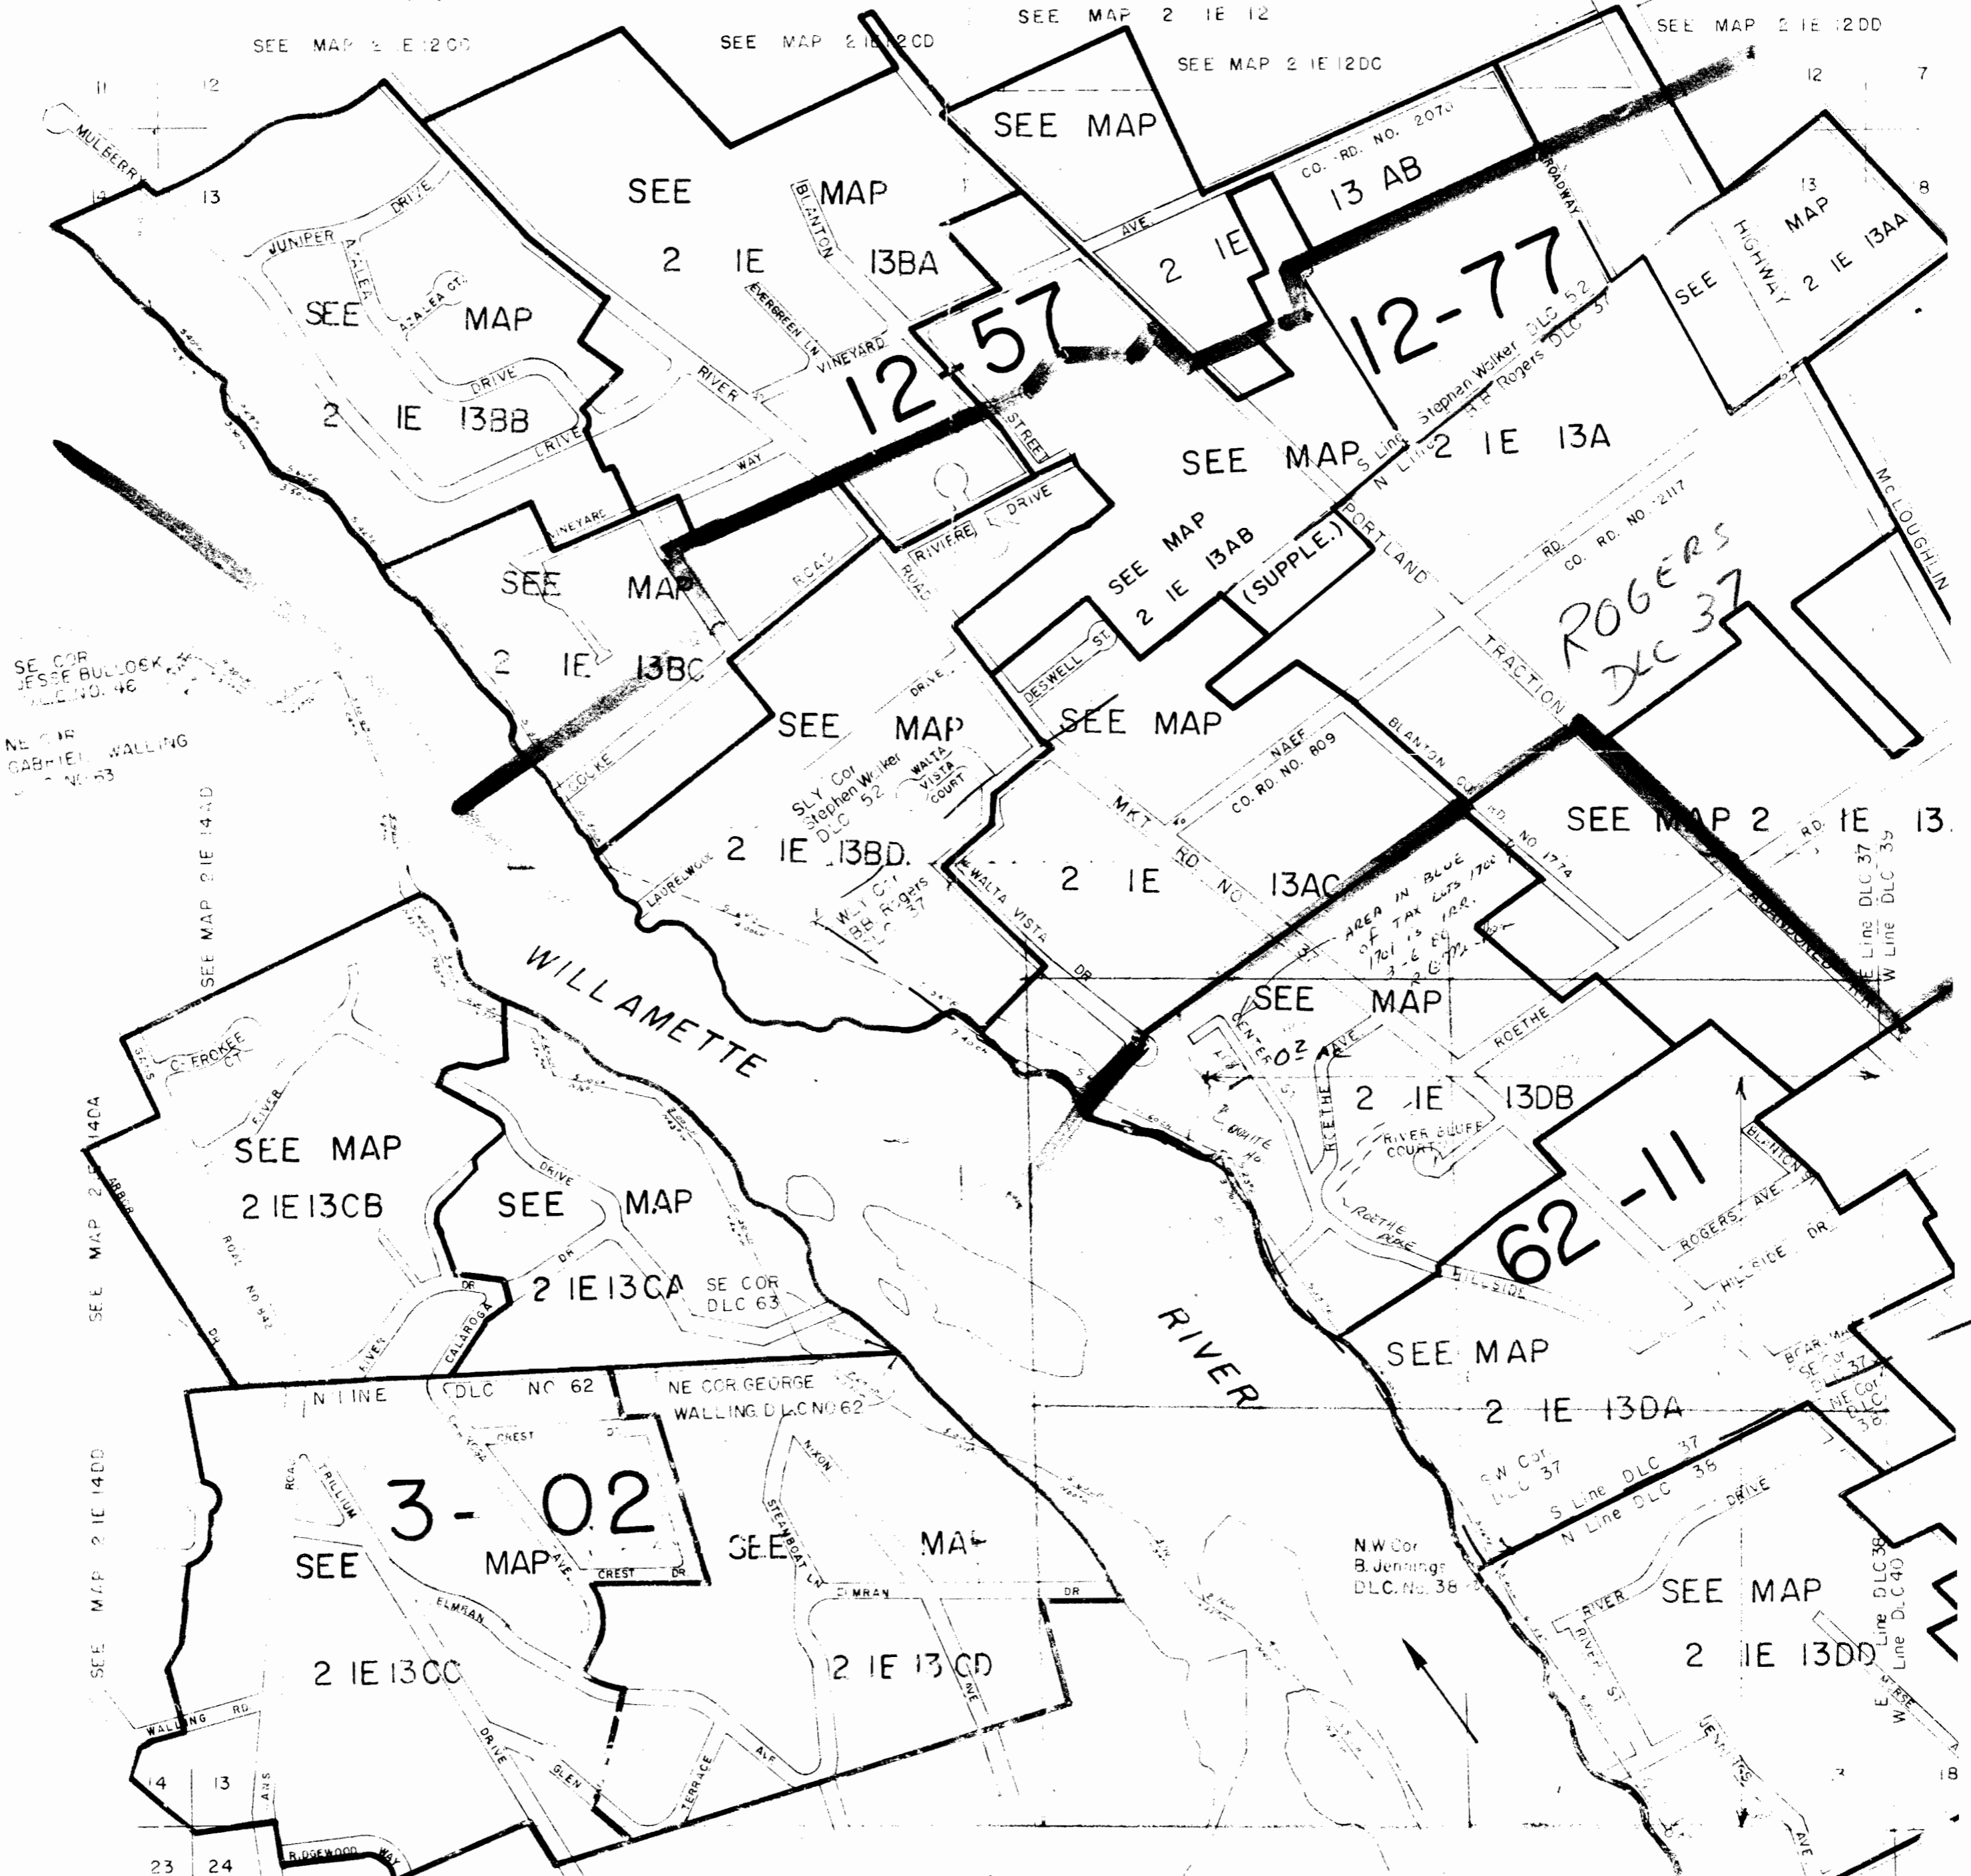

SE COR  
JESSE BULLOCK  
DLC NO. 46

NE COR  
GABRIEL WALLING  
DLC NO. 53

SEE MAP 2 IE 14AD

SEE MAP 2 IE 14DA

SEE MAP 2 IE 14DD

SEE MAP  
2 IE 13CB

SEE MAP

2 IE 13CA  
SE COR  
DLC 63

SEE MAP

2 IE 13CC

SEE MAP

2 IE 13CD

SEE MAP

SEE MAP

2 IE 13BA

SEE MAP 2 IE 12

SEE MAP 2 IE 12DC

13 AB

2 IE

SEE MAP 2 IE 12DD

12 7

13

13  
HIGHWAY 2 IE 13AA

12-57

12-77

SEE MAP 2 IE 13A

SEE MAP

2 IE 13BC

SEE MAP

SEE MAP

SEE MAP 2 IE 13AB  
(SUPPLE.)

RD. NO. 2117

ROGERS  
DLC 37

2 IE 13BD

2 IE NO 13AC

SEE MAP 2 IE 13

SEE MAP

2 IE 13DB

62-11

SEE MAP

2 IE 13DA

3-02

NW Cor  
B. Jennings  
DLC No. 38

SEE MAP

2 IE 13DD

Line DLC 38  
Line DLC 40