


T.35S., R.6 W., W.M.

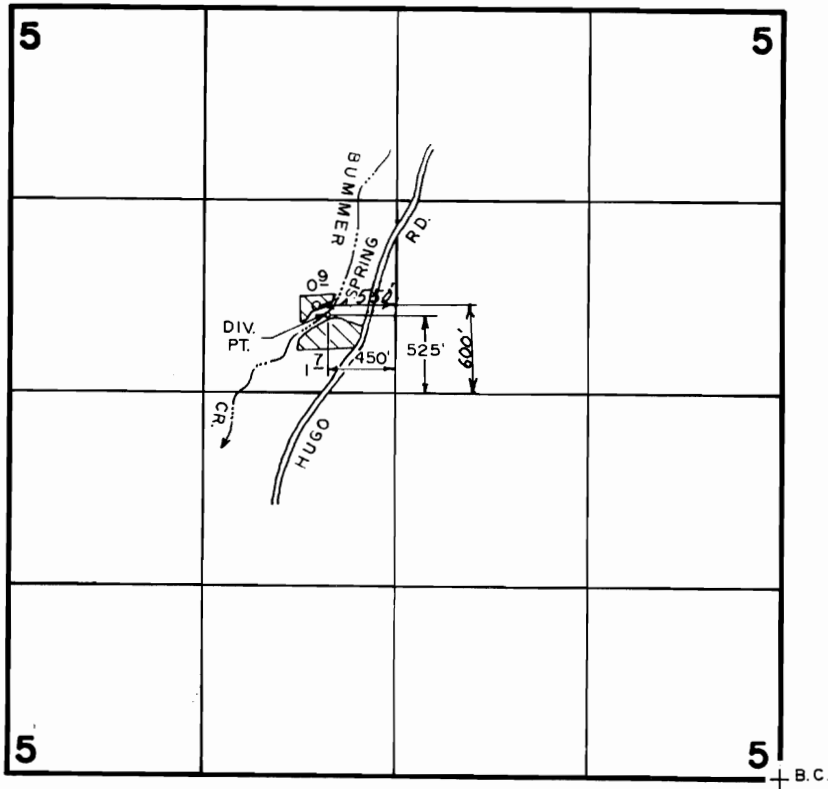

FINAL PROOF SURVEY
UNDER

TRANSFER NO. 4165
Application No. 56465 Permit No. 42545
IN NAME OF

PAUL E. JONAS

Surveyed SEPT. 28 19 82 by B. SUZIE JAMES

SCALE: 4" = 1 MILE

RECEIVED

AUG 10 1982

WATER RESOURCES CENTER
SALEM REGION