


T. 29 S., R. 4 W., W.M.

SECTION 21

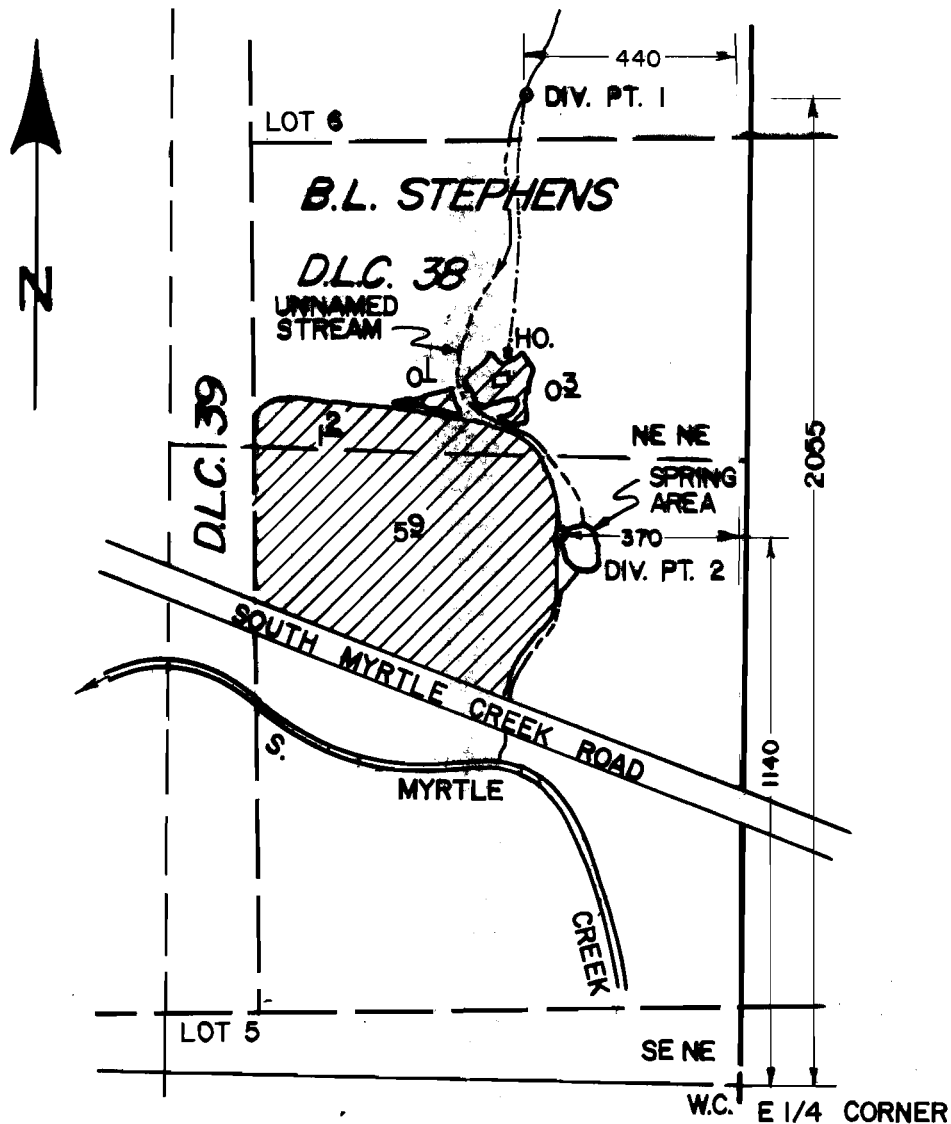

SCALE: 1" = 400'

FINAL PROOF SURVEY
UNDER

Application No. ...56978.. Permit No. ...42899.....
IN NAME OF

.....WAYNE A. SNYDER.....

Surveyed OCT. 5, 1983, by ...L.E. CASHION...
MAY 8, 1986, by J.M. SCHMORDE