


T. 33., R. 1 W., W. M.

Sec. 36

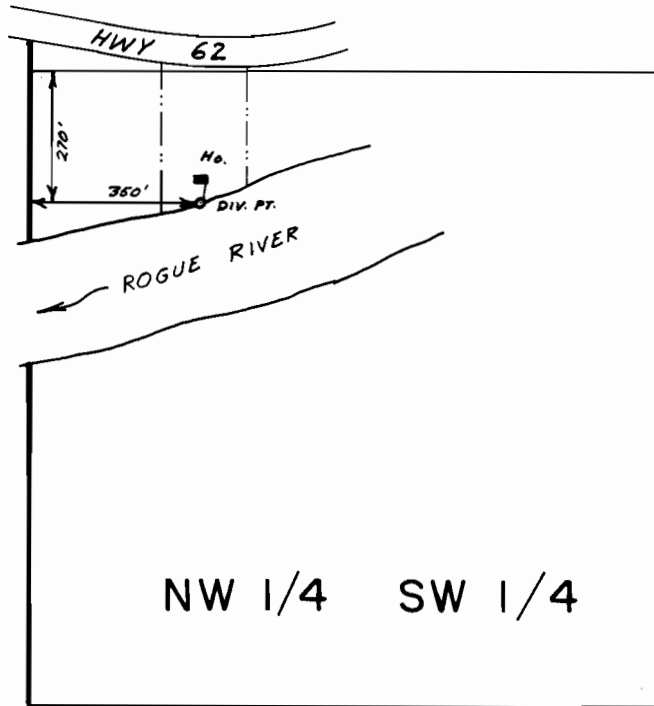

Scale 1" = 400'

FINAL PROOF SURVEY
UNDER

Application No. 51028.. Permit No. 42946.....
IN NAME OF

DAVID & BARBARA PANIETZ.....

Surveyed JUNE 12, 1986, by B.S. JAMES.....