


T.35S., R.7W., W.M.

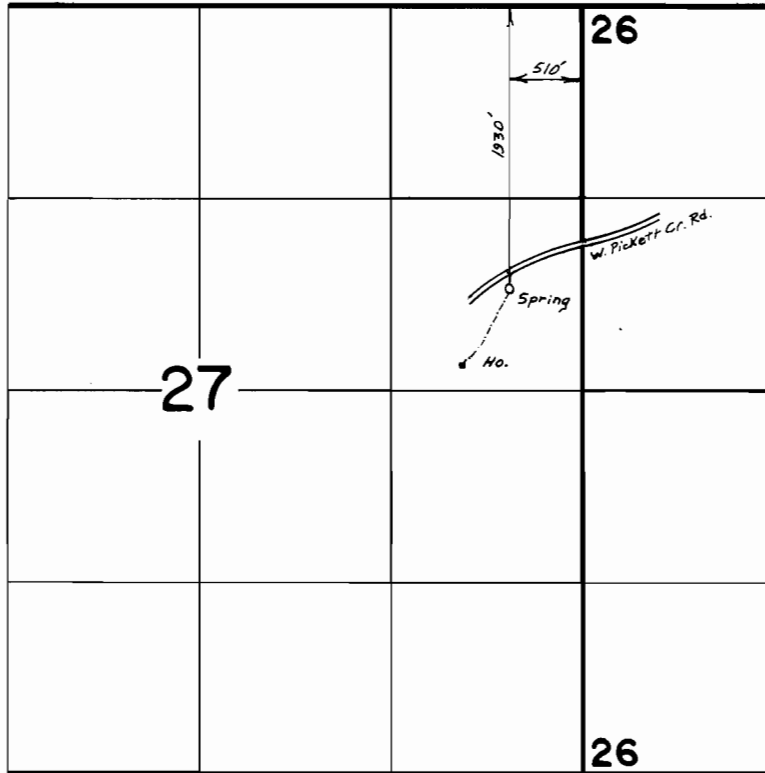

Scale 1"=1320'

FINAL PROOF SURVEY
UNDER

Application No. 57413.. Permit No. 43272.....
IN NAME OF

.....TIMM ANDERSEN.....

Surveyed Oct. 27, 1985, by B.S. JAMES.....