


T.26S., R.5W., W.M.

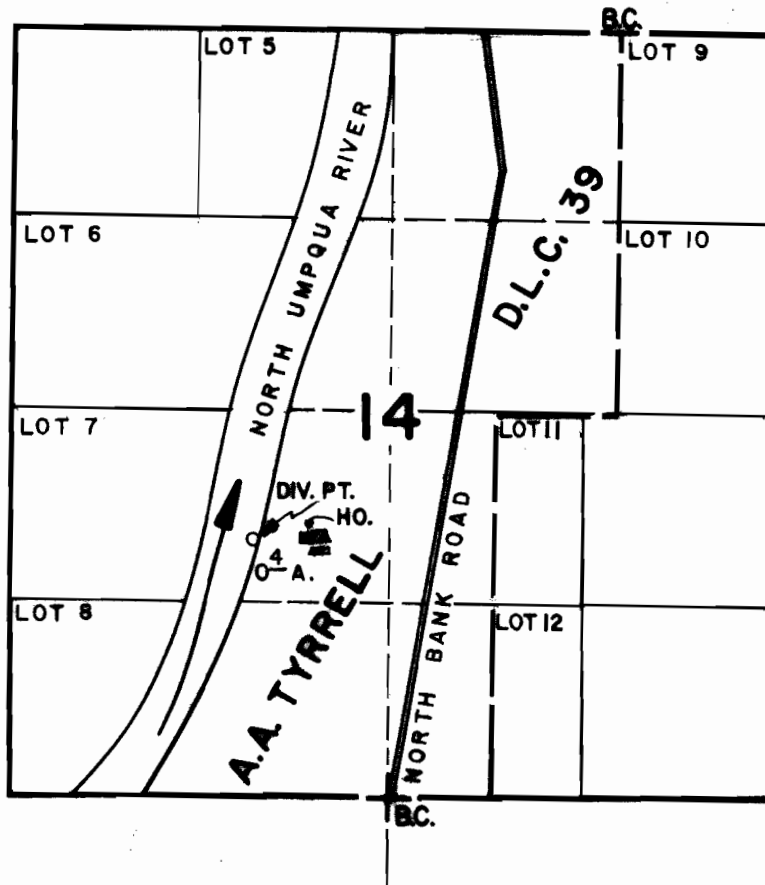

DIV. LOCATED 1750' N. & 940' W. OF S. 1/4 CORNER SEC.14.

SCALE: 4" = 1 MILE
FINAL PROOF SURVEY
UNDER

Application No. **58990** Permit No. **44841**
IN NAME OF

LOGAN, EVA T.

Surveyed **JUNE 26, 1985**, by **J.M. SCHMORDE**