


T. 26 S., R. 4 W., W.M.

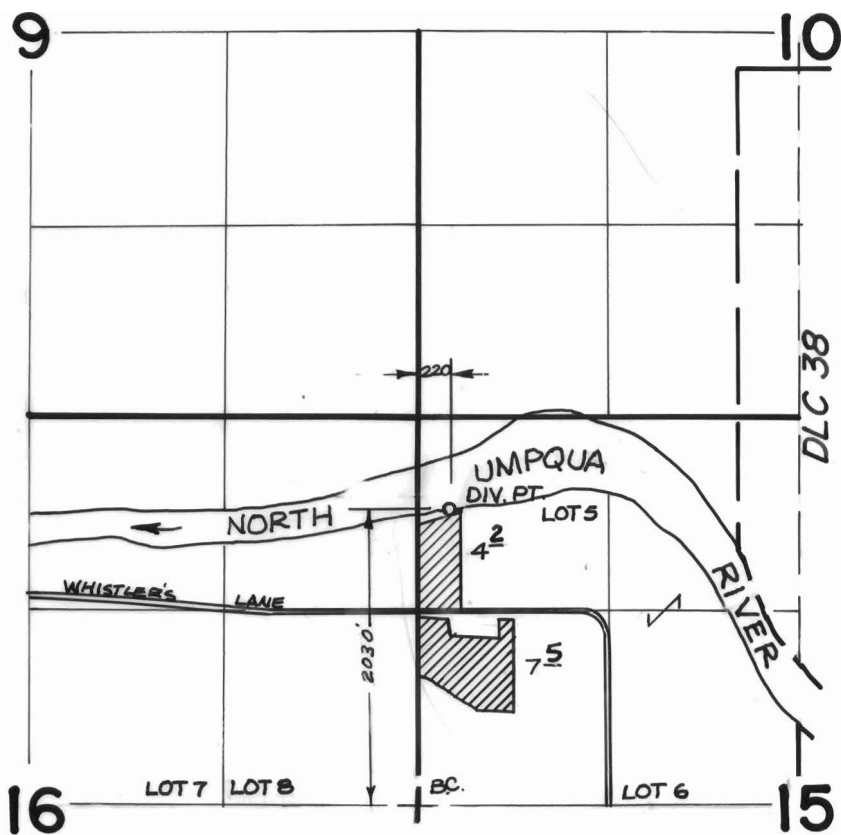

SCALE: 4" = 1 MILE

FINAL PROOF SURVEY UNDER

Application No. ...60054. Permit No.45075....
IN NAME OF

.....JAMES WILSON.....

Surveyed ..SEPT..8, 19..86, by ...J.M..SCHMORDE.