


T. 37S., R. 14 W., W.M.

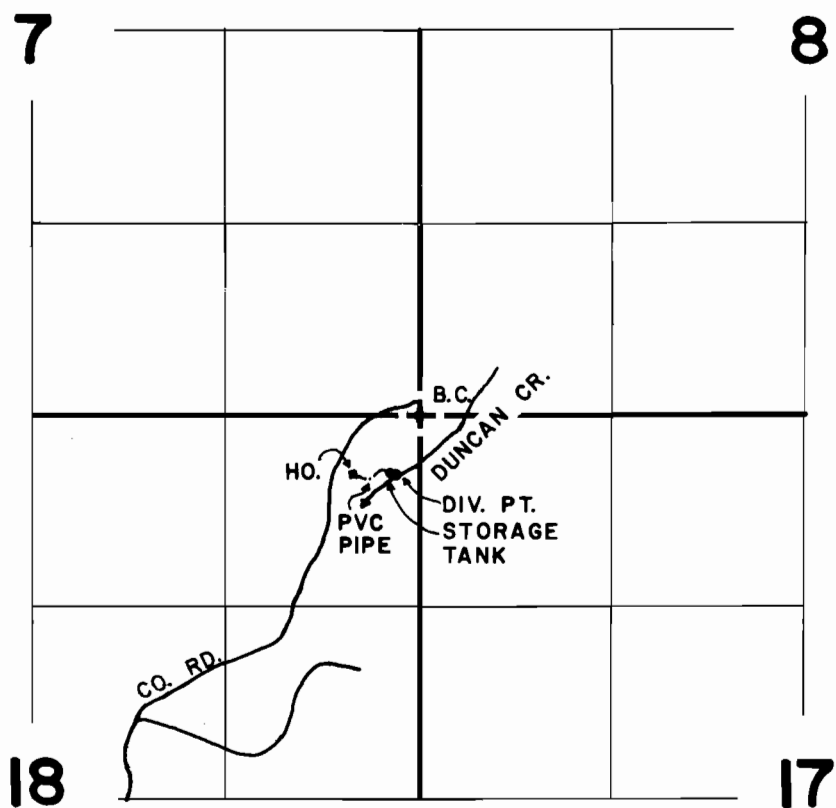

DIV. PT. LOCATED 400' S. & 150' W. FROM NW COR. SEC. 17.

SCALE: 4" = 1 MILE

FINAL PROOF SURVEY
UNDER

Application No. 60554 Permit No. 45233
IN NAME OF

MRS. EDWARD JARMAN

Surveyed SEP. 24. 1985, by J.M. SCHMORDE