


T. 37 S., R. 14 W., W.M.

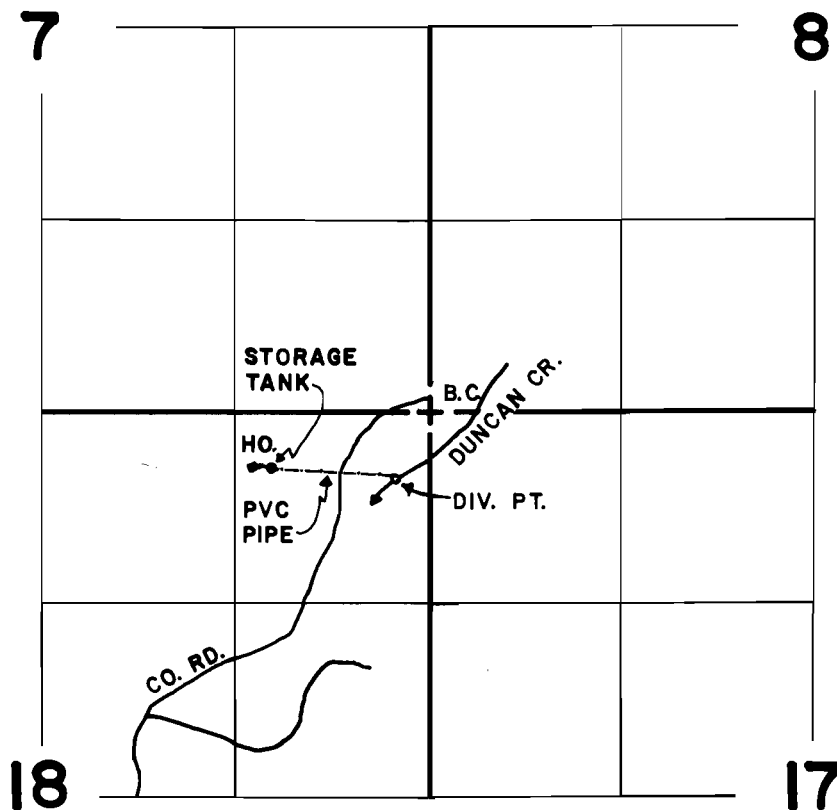

DIV. PT. LOCATED 450' S. & 240' W. FROM NE COR. SEC. 18.

SCALE: 4" = 1 MILE

FINAL PROOF SURVEY
UNDER

Application No. 60555 Permit No. 45234.....
IN NAME OF

ROBERT SNAZUK

Surveyed SEP. 24. 1985, by J.M. SCHMORDE