


T. 37S., R. 14 W., W.M.

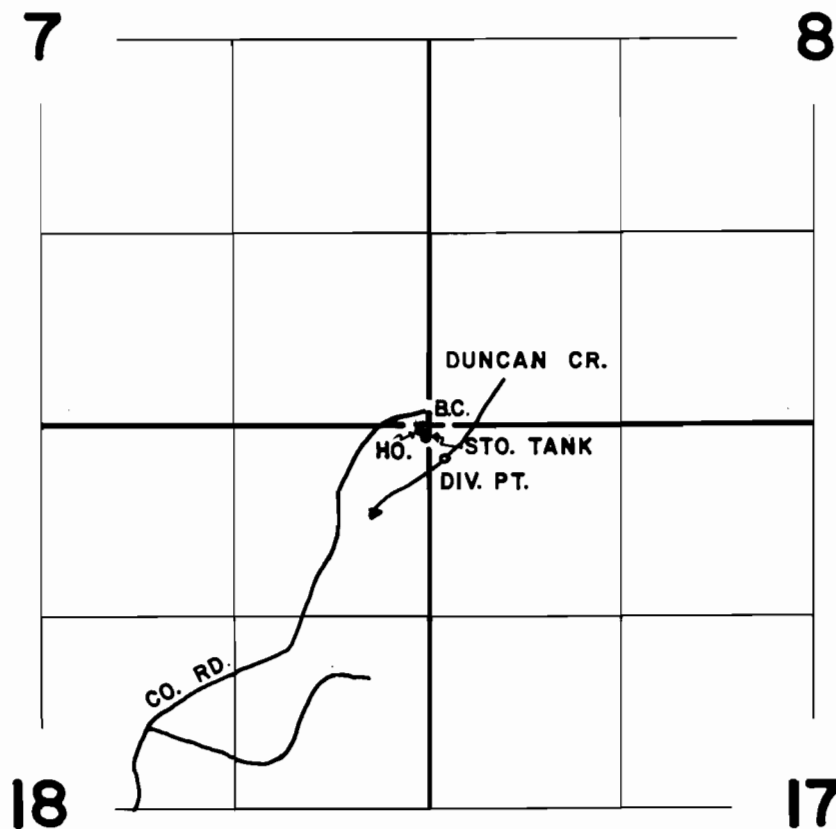

DIV. PT. LOCATED 230' S. & 100' E. FROM NW COR. SEC. 17.

SCALE: 4" = 1 MILE

FINAL PROOF SURVEY UNDER

Application No. 60556. Permit No. 45235.....
IN NAME OF

JOSEPH N. SNAZUK

Surveyed SEPT. 24 1985, by J.M. SCHMORDE