




T. 6 S., R. 10 W., W.M.

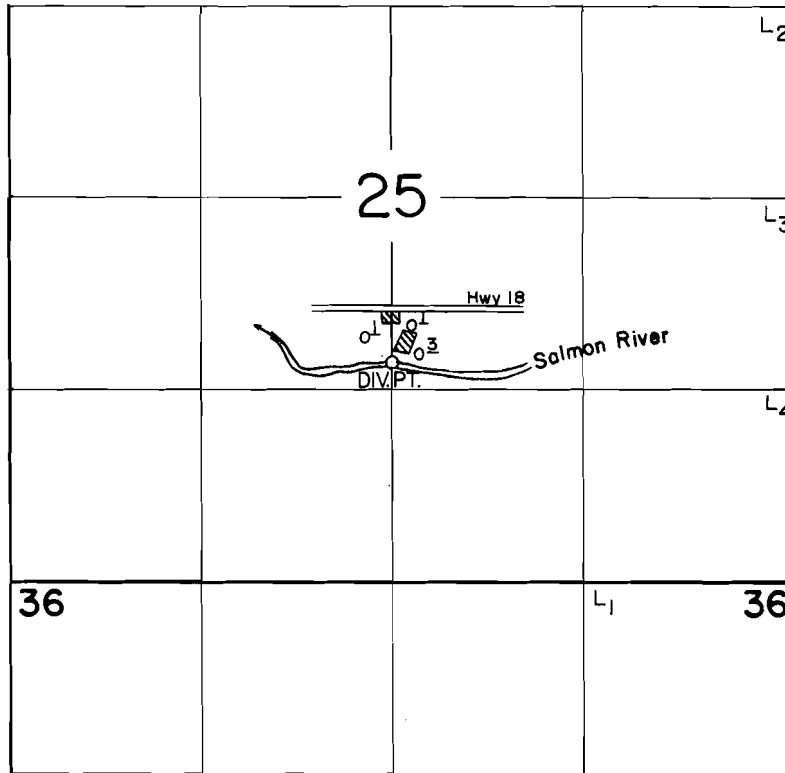

DIV. PT. LOC: 1140' S. & 1330' E. FROM N.E. CORNER NW 1/4 SW 1/4 SEC. 25

SCALE: 1" = 1320'

FINAL PROOF SURVEY UNDER

Application No. 61816..... Permit No. 45779.....
IN NAME OF

HENRY F. PAPINEAU

Surveyed AUG. 4..... 1986, by T. WARREN.....