


T. 3 N., R. 2 W., W.M.

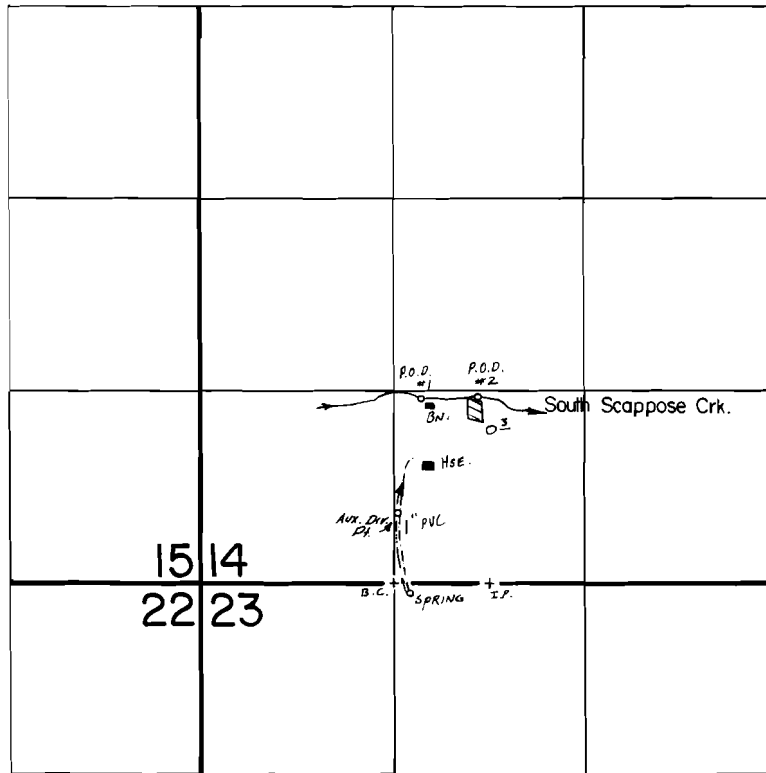

P.O.D. 1 Loc.: 1260' N. & 1520' E.  
 P.O.D. 2 Loc.: 1280' N. & 1910' E.  
 Spring Loc.: 180' S. & 1450' E., all from SW Cor. Sec. 14.  
 AUX. DIV. PT.: 480' N. & 1350' E., from SW Cor. Sec. 14

Scale: 1" = 1320'

**FINAL PROOF SURVEY**  
 UNDER

60185 45792  
 Application No. 63066 Permit No. 46464  
 IN NAME OF

MAPLE HILL CATTLE RANCH, by DEANE S. CHAPPELL, owner

Surveyed May 22 1984, by B. Bishop  
 & June 2 1986, by T. Warren