90684

T. 3 N., R. 2 W., W. M.

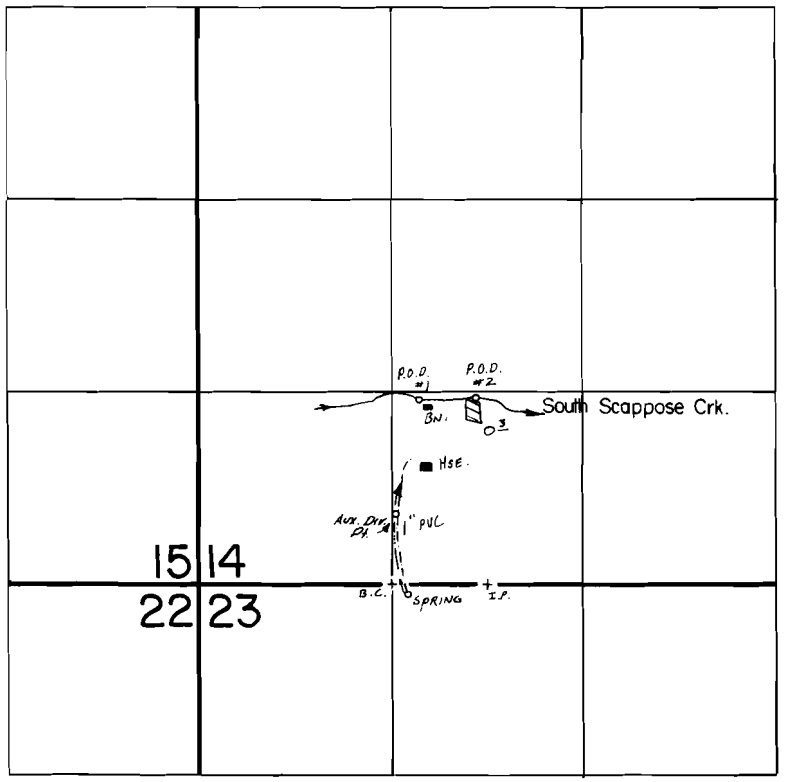

P.O.D. 1 Loc.: 1260' N. & 1520' E.
P.O.D. 2 Loc.: 1280' N. & 1910' E.
Spring Loc.: 180' S. & 1450' E., all from SW Cor. Sec. 14.
AUX. DIV. PT.: 480' N. & 1350' E., from SW Cor. Sec. 14

Scale: 1" = 1320'

FINAL PROOF SURVEY
UNDER

Application No. 60185 / 63066 Permit No. 45792 / 46464
IN NAME OF

MAPLE HILL CATTLE RANCH, by DEANE S. CHAPPELL, owner

Surveyed May 22 1984, by B. Bishop
& June 2 1986, by T. Warren

PTS-1986-A
12/31/86 TMW