


T.28S. R.6W. W.M.

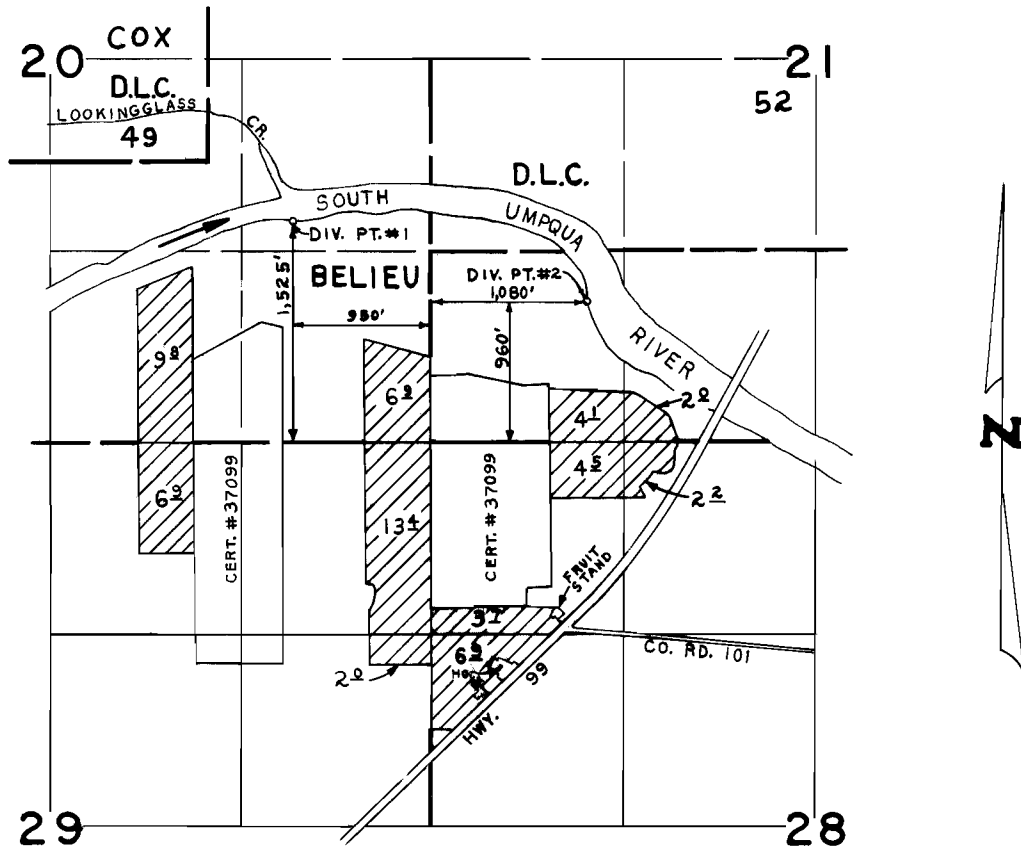

SCALE: 4" = 1 mile

FINAL PROOF SURVEY UNDER

Application No. 63428. Permit No. 46774.....
IN NAME OF

DAVID K. BURKS

Surveyed DEC. 8, 1983, by L. CASHION.....