


# T. 26 S., R. 4 W., W.M.

## SECTION 21

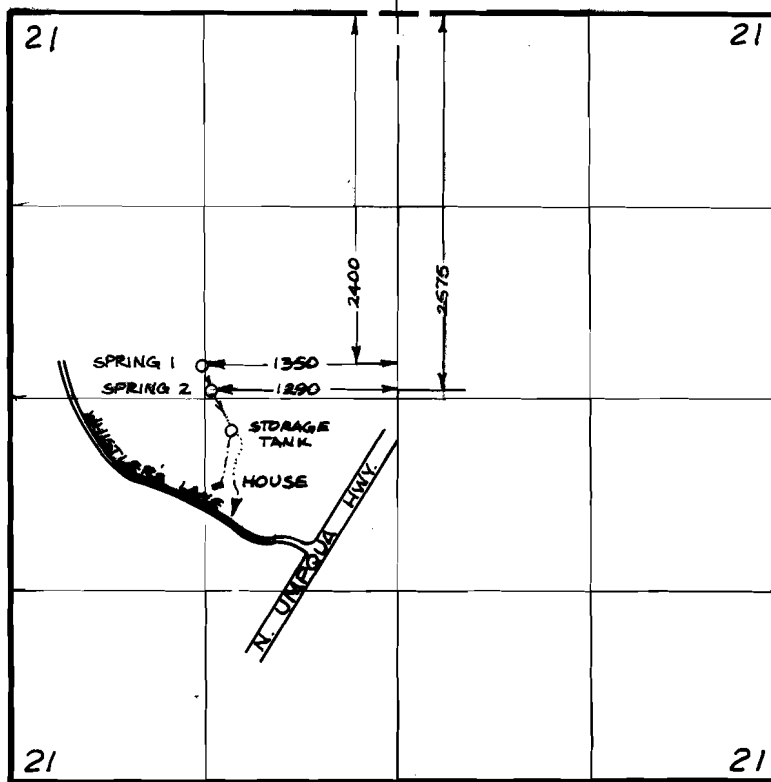

SCALE : 4" = 1 MILE

### FINAL PROOF SURVEY UNDER

Application No. 63849 Permit No. 47262  
IN NAME OF

GEORGE G. ROONEY

Surveyed SEPT. 10, 19. 86, by J.M. SCHMORDE.