


P-47333
C-56611

T. 13S., R. 28E., W.M.

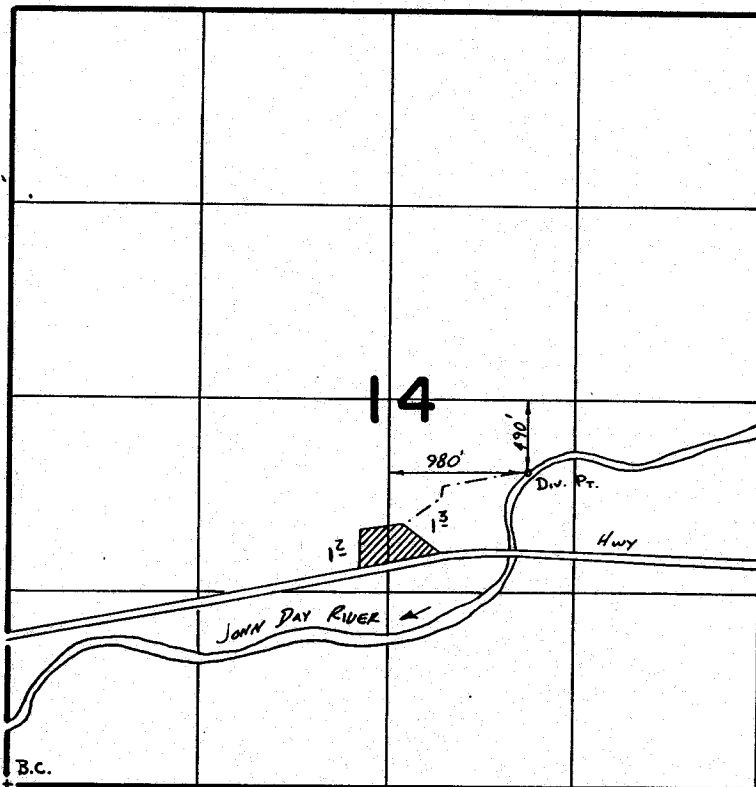

SCALE 1" = 1320'



FINAL PROOF SURVEY
UNDER

Application No. **64568** Permit No. **47333**
IN NAME OF

JOHN & JEAN DeBONA

Surveyed **3-20** 19**86**, by **V.L. Church**