


T. 26 S., R. 4 W., W.M.

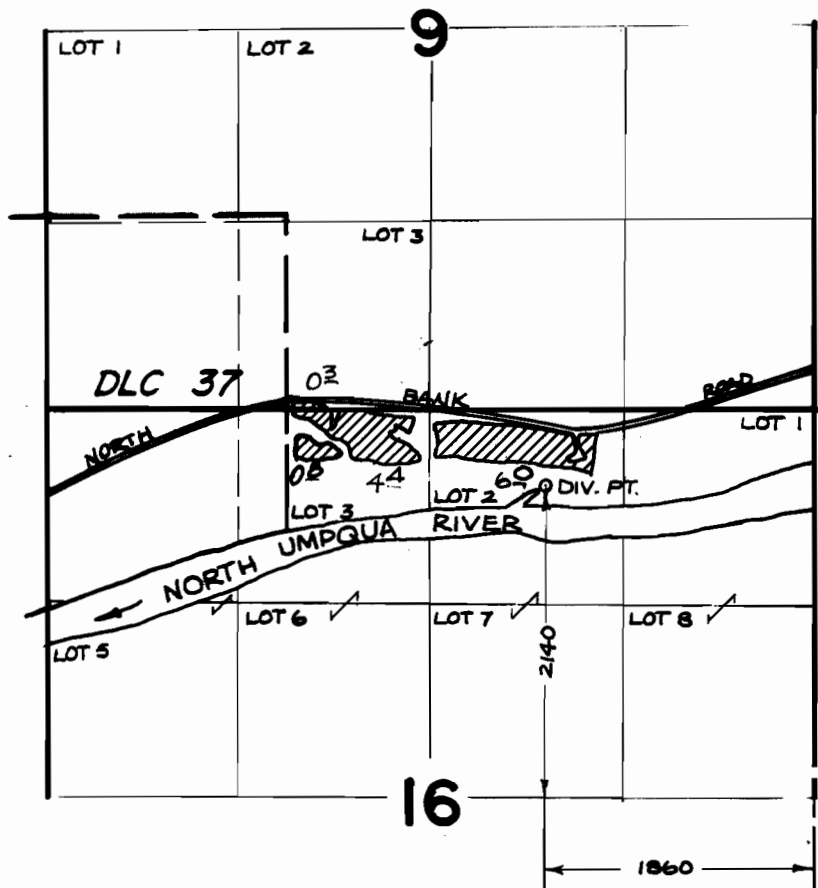

SCALE : 4" = 1 MILE

FINAL PROOF SURVEY UNDER

Application No. ...65331. Permit No.47698...
IN NAME OF

.....MARION E. CARL.....

SurveyedSEPT. 11, 19. 86, by ...J.M. SCHMORDE.