


T. 26 S., R. 4 W., W.M.

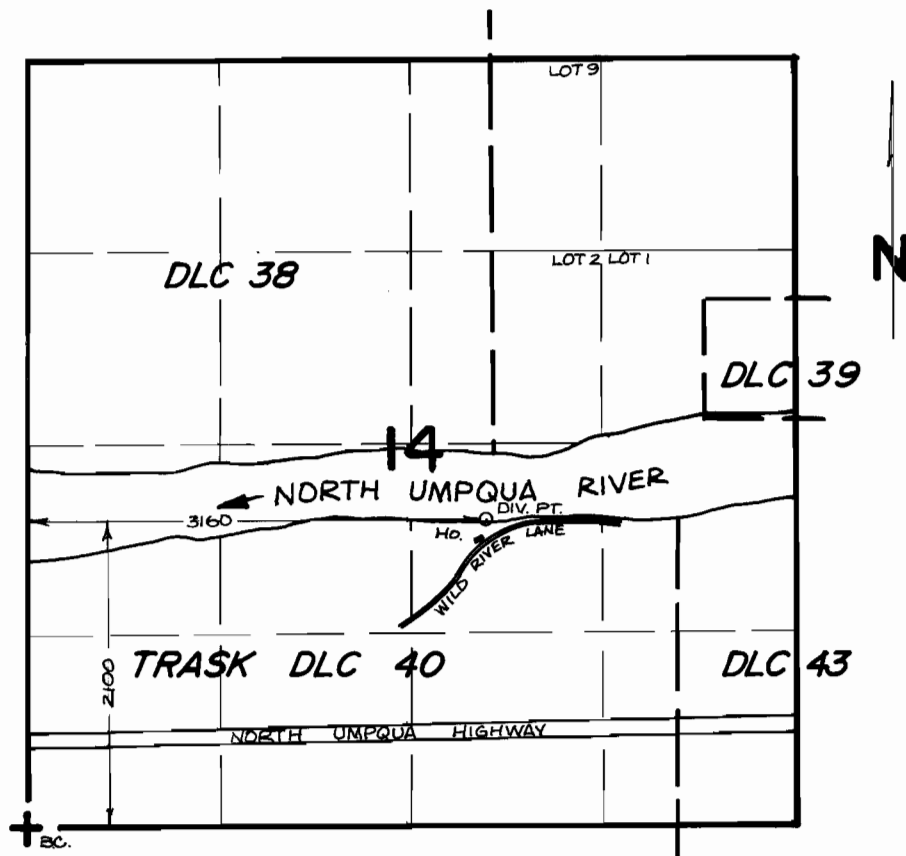

SCALE : 4" = 1 MILE

FINAL PROOF SURVEY UNDER

Application No. ..6.7963 Permit No.4.7908...
IN NAME OF

.....GORDON E. CROOK.....

Surveyed ..SEPT. 4, 19.86, by ..J.M. SCHMORDE.