


T. 26 S., R. 4 W., W.M.

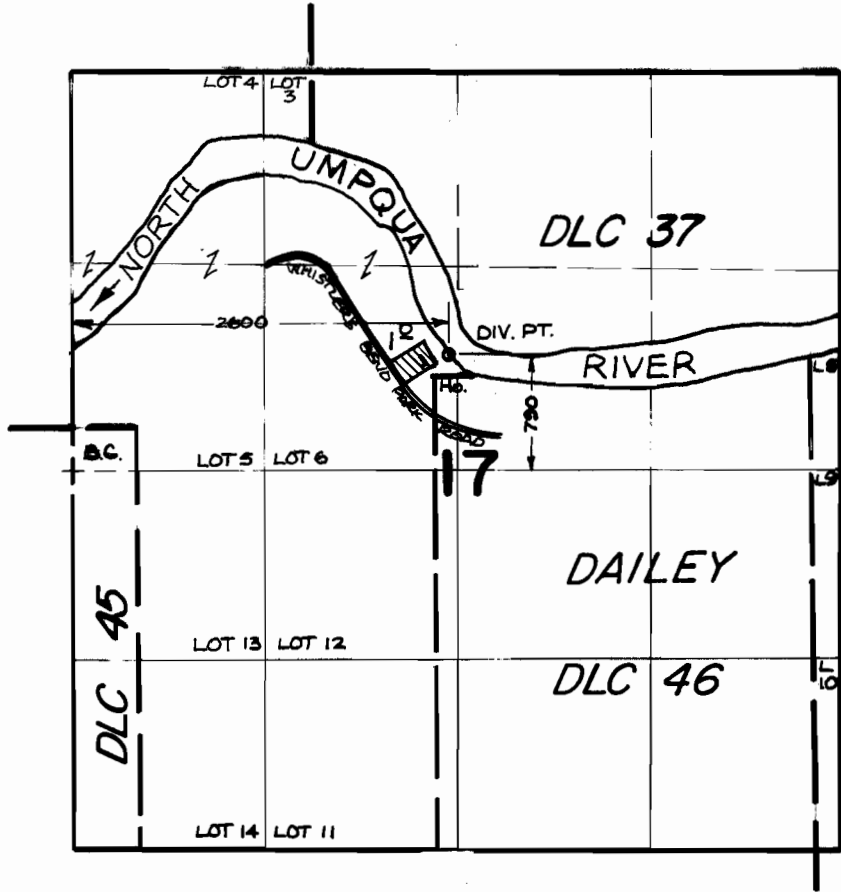

SCALE : 4" = 1. MILE

FINAL PROOF SURVEY UNDER

Application No. ..65307.. Permit No.47932....
IN NAME OF

.....MARTIN W. SCHNEIDER.....

Surveyed ..SEPT. 10, 19 86, by ..J.M. SCHMORDE