


T. 26 S., R. 4 W., W.M.

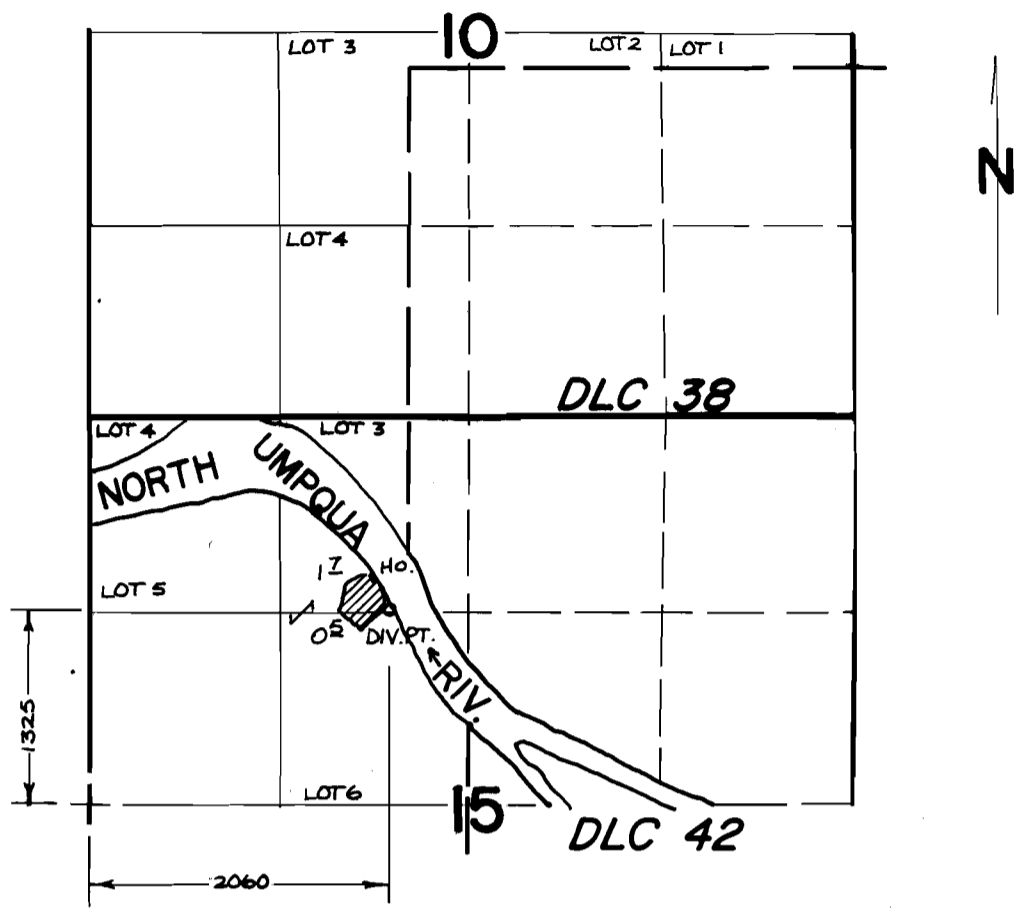

SCALE: 4" = 1 MILE

FINAL PROOF SURVEY UNDER

Application No. ...65588. Permit No.48013....
IN NAME OF

.....HAROLD H. YOUNG.....

Surveyed ..SEPT..3, 19.86., by ..J.M. SCHMORDE...