


# T.5S. R.2W. W.M.

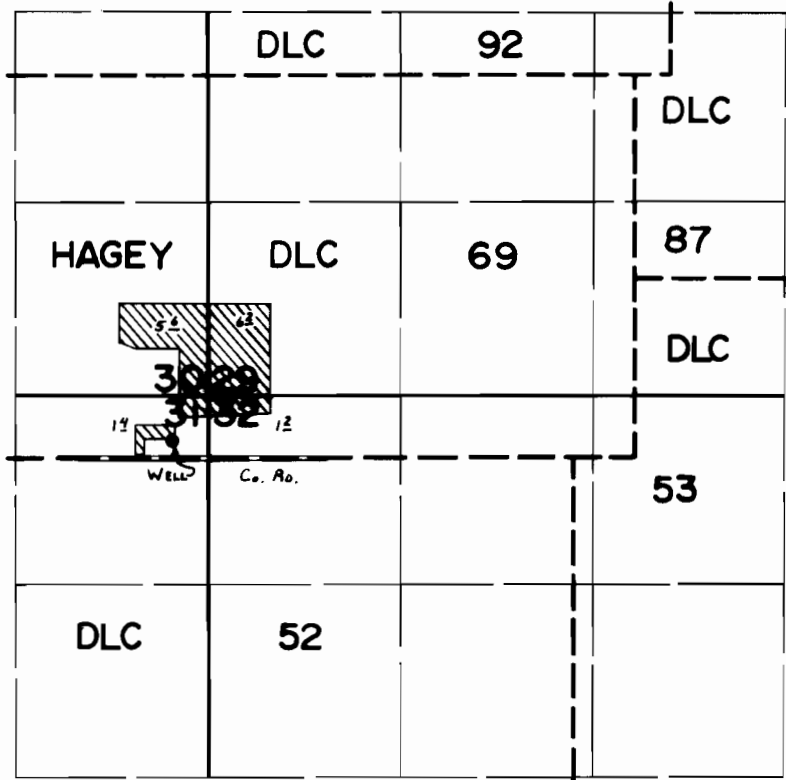

WELL Loc: 310' S. & 230' W. fr. N.E. Cor. Sec. 31.

## FINAL PROOF SURVEY UNDER

Application No. ~~G-6184~~. Permit No. ~~G-5861~~.....  
IN NAME OF

.....**PHILIP ZHARKOFF**.....

Surveyed July...11... 1980, by ..C.L. Hughes.....