


T.6S. R.2W. W.M.

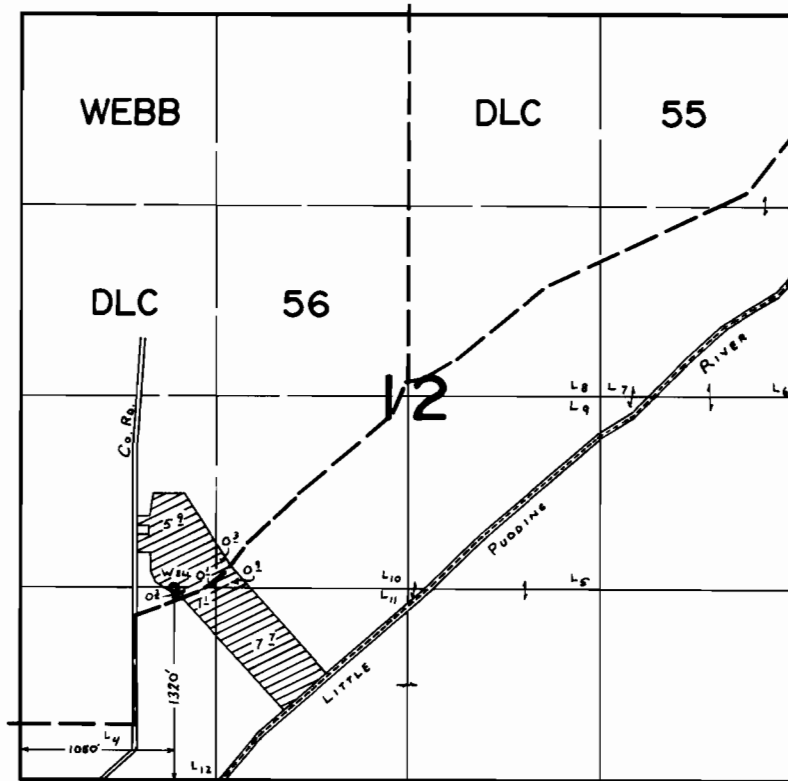

FINAL PROOF SURVEY
UNDER

Application No. G-6856. Permit No. G-6395....
IN NAME OF

.....**JOSEPH PFAU**.....

Surveyed July...9... 19.80, by ...C..L..Hughes.....