


G-6846
5620

T. 6 N. R. 36 E. W. M.

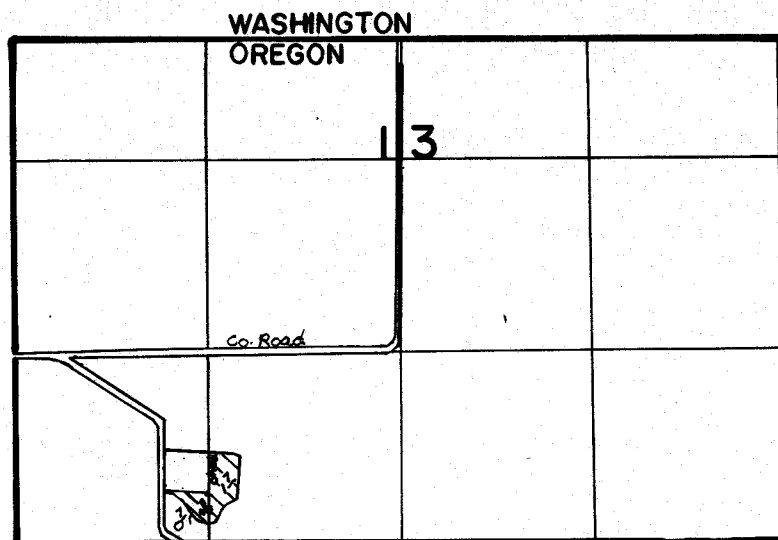

SCALE: 1" = 1320'



WELL LOC. 880' S. & 40' E. FROM N.W. COR. SE 1/4 SW 1/4 Sec 13

FINAL PROOF SURVEY
UNDER

Application No. G-6572. Permit No. G-6846.....
IN NAME OF

.....WILLIAM R. & DAVID E. HOUGHIN.....

Surveyed 4-24..... 1984., by V.L. CHURCH.....

Basin 7 misc. wells