


G-7382
56621

T. 26 S., R. 14 E., W. M.

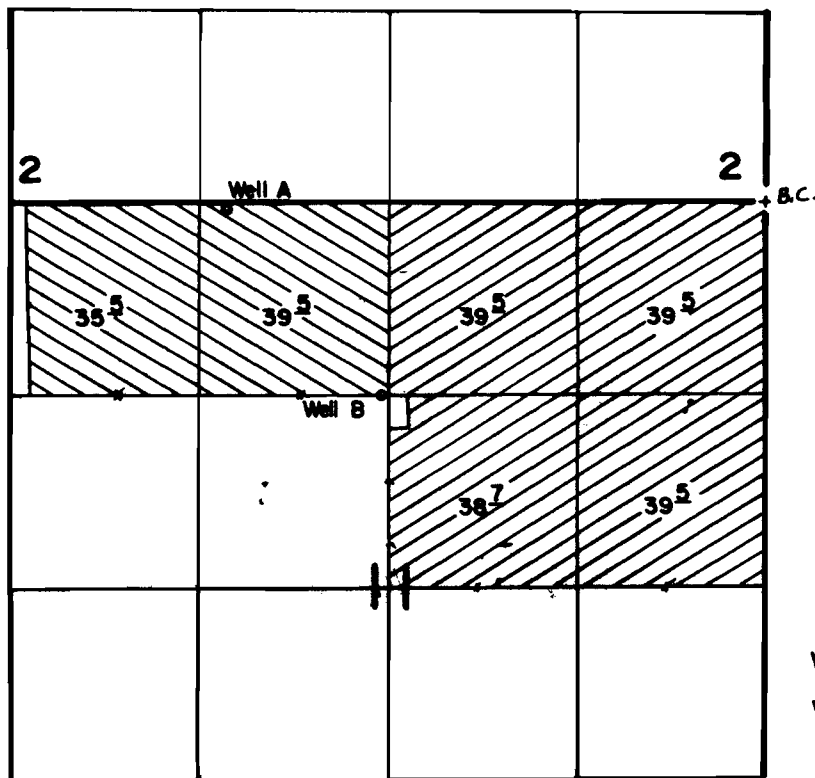

Well "A" Loc.: 50' S. & 3710' W.; Well "B" Loc.: 1330' S. & 2650' W.;
both from NE Cor. Sec. II.

Scale: 1" = 1320'

FINAL PROOF SURVEY UNDER

Application No. G-7863. Permit No. G-7382....
IN NAME OF

ANDREW BETTENCOURT

Surveyed Oct. 13, 1984, by Pete Foster

PTS PRP 11/20/84
RE-DRAFT TAW 6/10/87