


T. 11S. R. 2W. W.M.

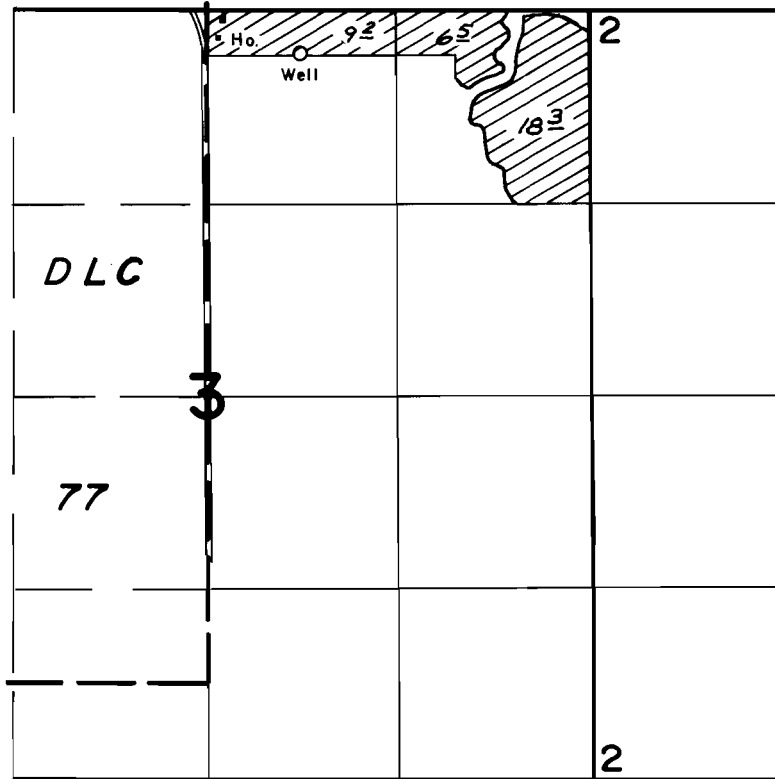

Well Loc. - 290' S & 1980' W from N.E. Cor. Sec. 3

FINAL PROOF SURVEY UNDER

Application No. ~~G-8013~~ Permit No. ~~G-7420~~..
IN NAME OF

..... BERNARD BENSON

Surveyed JULY 2, 1979, by S.C. BROWN.....