


T.16S.,R.4W.,W.M.

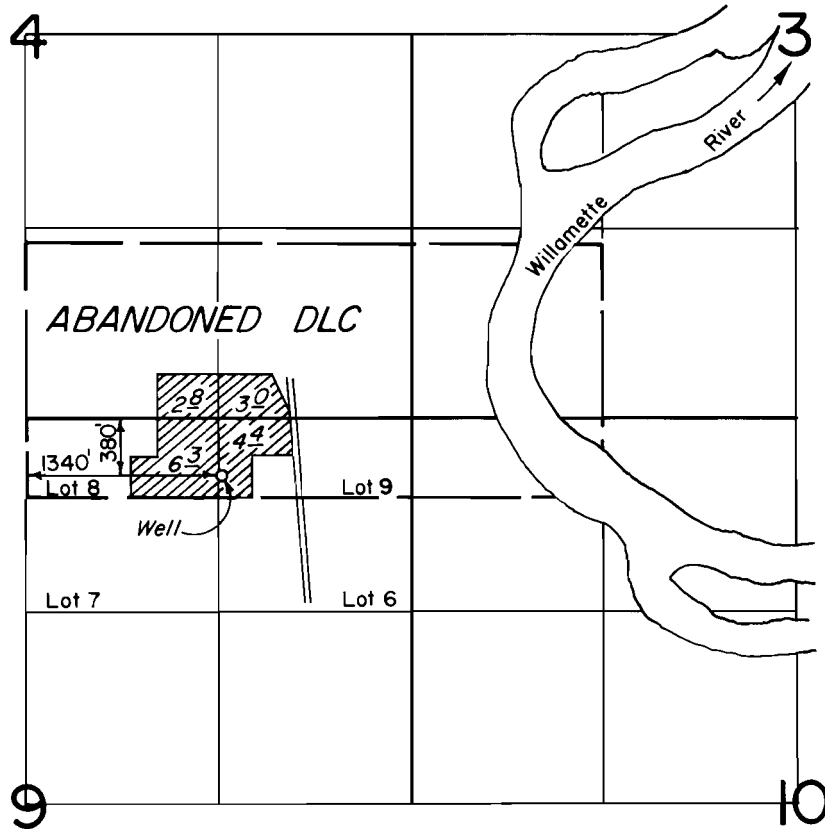

FINAL PROOF SURVEY
UNDER

Application No. G-7829 Permit No. G-7538

IN NAME OF

WALTER EDWARDS

Surveyed MAY 8, 1980, by *Alfonso*