


T.15S.,R.48&5W.,W.M.

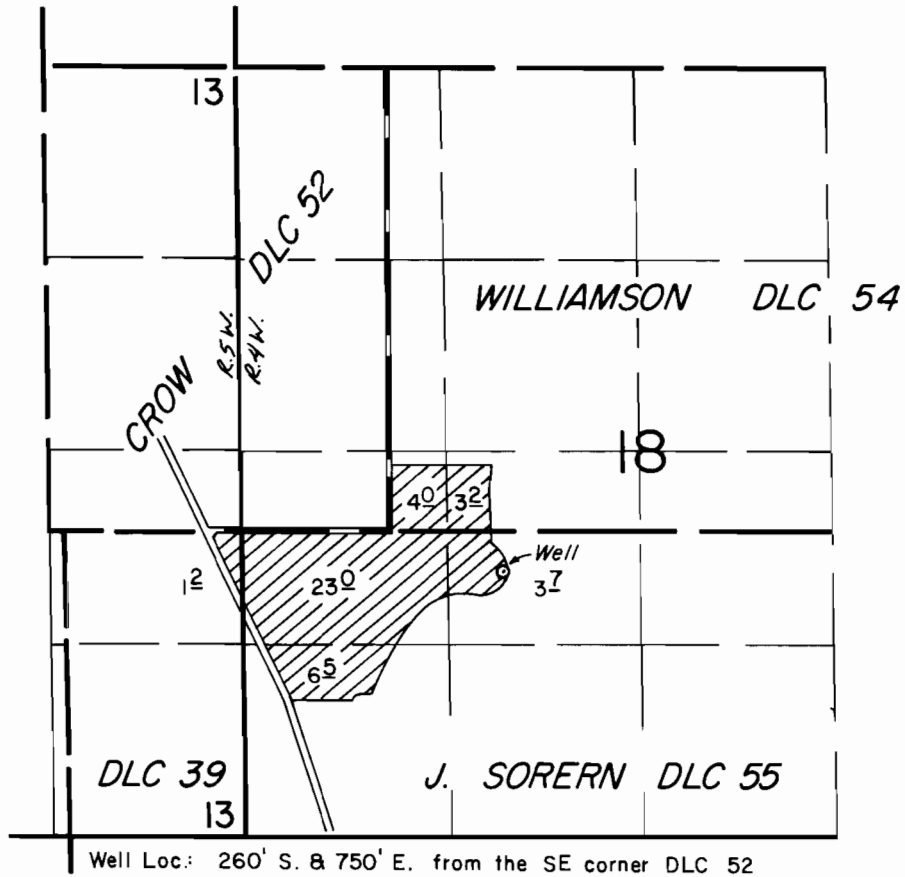

FINAL PROOF SURVEY
UNDER

Application No. G-8654 Permit No. G-7951.....
IN NAME OF

JAGER FARMS INC.

Surveyed MAY 8, 1980, by *[Signature]*.....