




T. 5 S., R. 1 E. & 1 W., W.M.

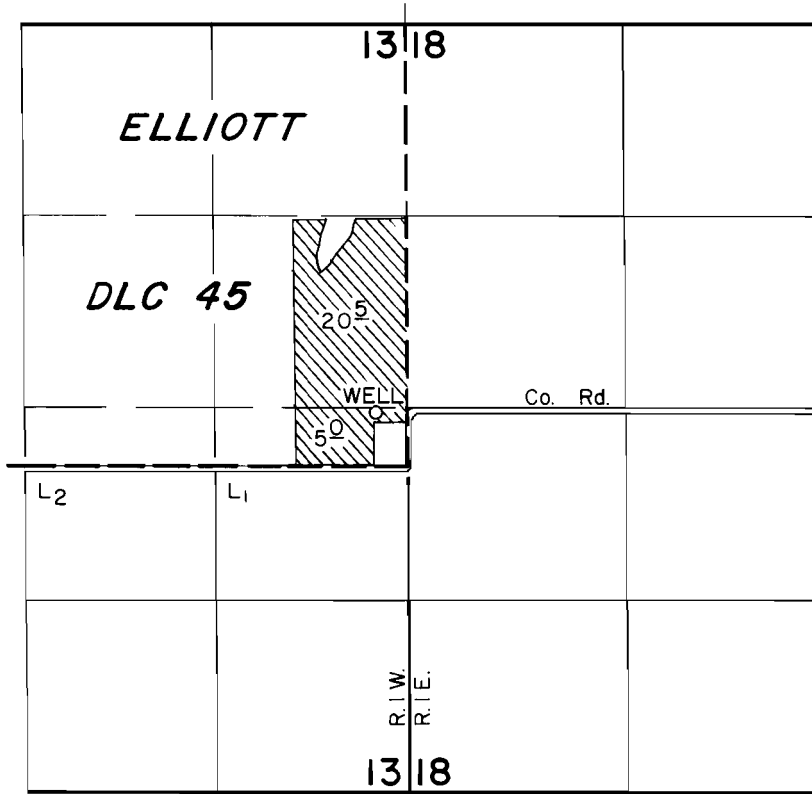

WELL LOC: 40'S. & 200' W. FROM THE E. 1/4 CORNER SECTION 13

SCALE: 1" = 1320'

FINAL PROOF SURVEY
UNDER

Application No. G-8194.. Permit No. G-8011.....
IN NAME OF

.....ALEXEY TIPIKIN.....

Surveyed JUNE 27, 1985., by T. WARREN.....