


T. 39 S., R. 8 W., W.M.

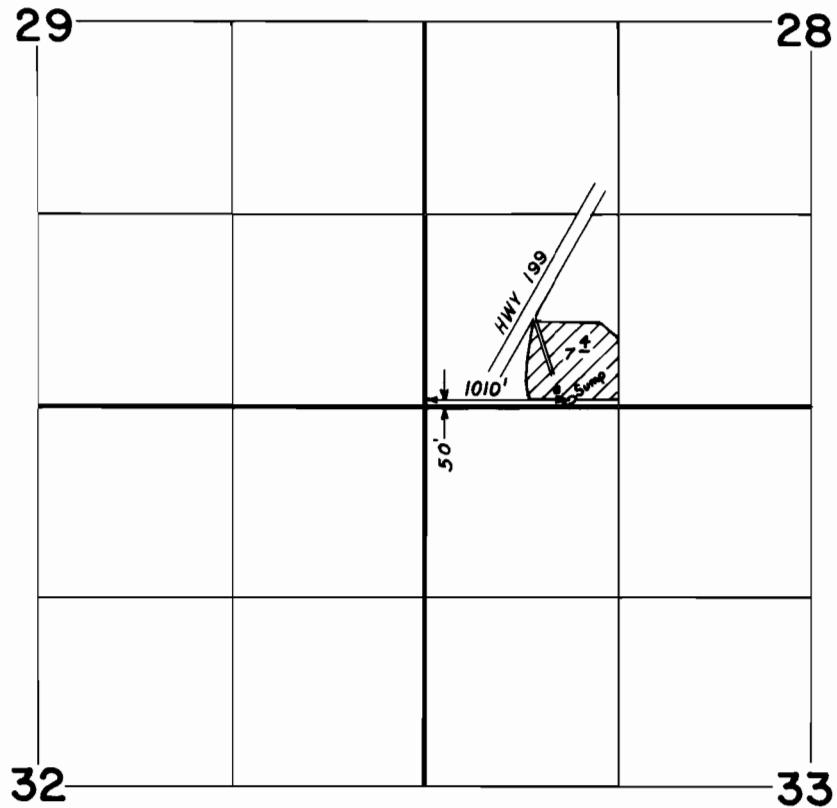

SCALE: 1"=1320'

FINAL PROOF SURVEY
UNDER

Application No. **G-8761** Permit No. **G-8106**
IN NAME OF

..... ARN ASSOCIATES

Surveyed **MAR. 27 1984**, by **B. S. JAMES**.....