


T.17S. R.2W. W.M.

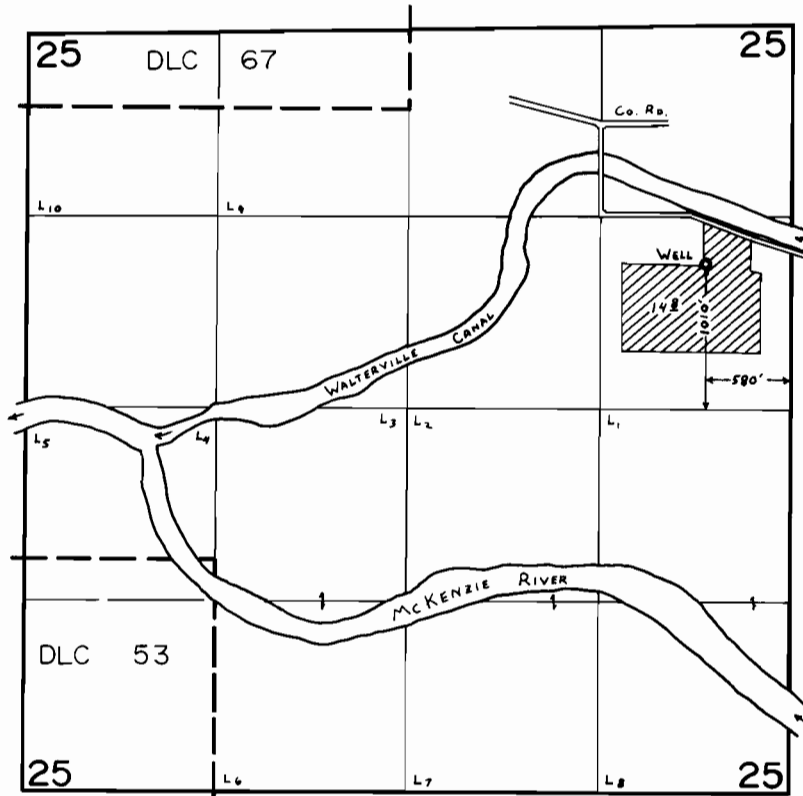

FINAL PROOF SURVEY
UNDER

Application No. G-8796 Permit No. G-8555.....
IN NAME OF

GENE TERPENING.....

Surveyed June 20, 1980, by C.L. Hughes.....