


T. 8 S. R. 39 E. W. M.

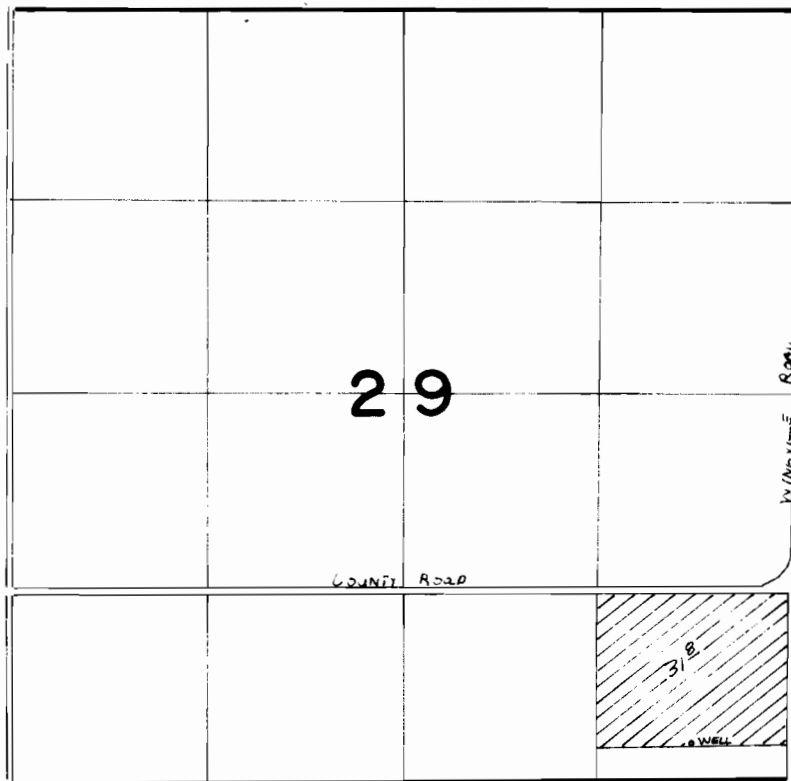

WELL LOCATED 250' NORTH AND 670' WEST FROM THE
S.E. COR. SEC. 29

FINAL PROOF SURVEY
UNDER

SCALE: 1" = 1320'

Application No. G-10235 Permit No. G-9260
IN NAME OF

VIRGIL H. BAILEY

Surveyed 7-19 1984, by V.L. CHURCH