




T. 1 S., R. 4 E., W.M.

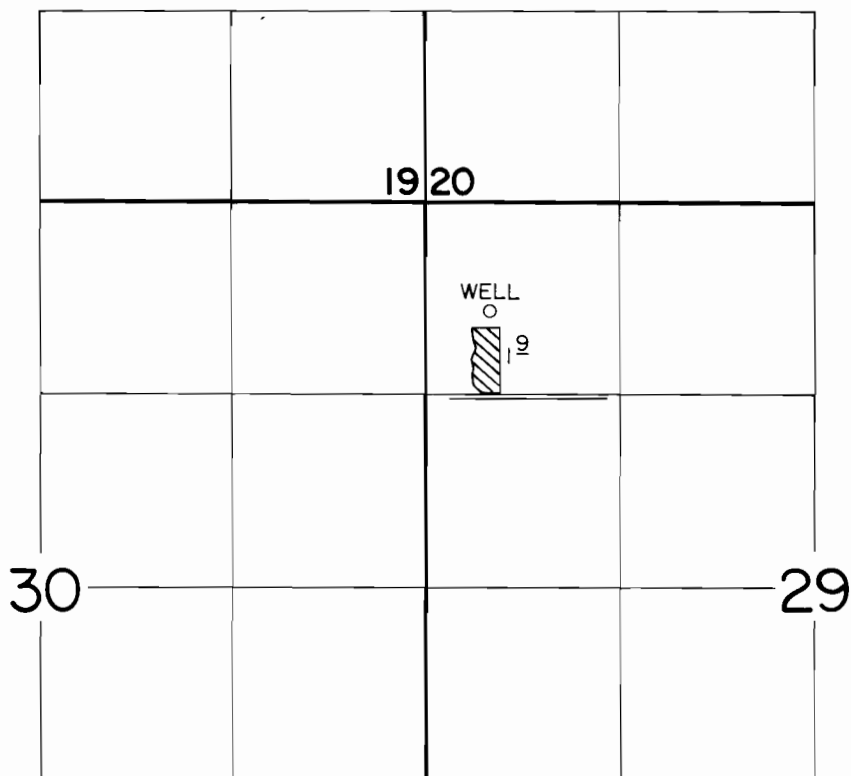

WELL LOC: 750'S. & 440'E. FROM NW. CORNER SECTION 29

SCALE: 1" = 1320'

FINAL PROOF SURVEY UNDER

Application No. G-10470 Permit No. G-9689
IN NAME OF

.....**WALTER L. PILOT**.....

Surveyed OCT. 9..... 1986, by T. WARREN.....