




T.18 & 19 S., R. 43 E., W.M.

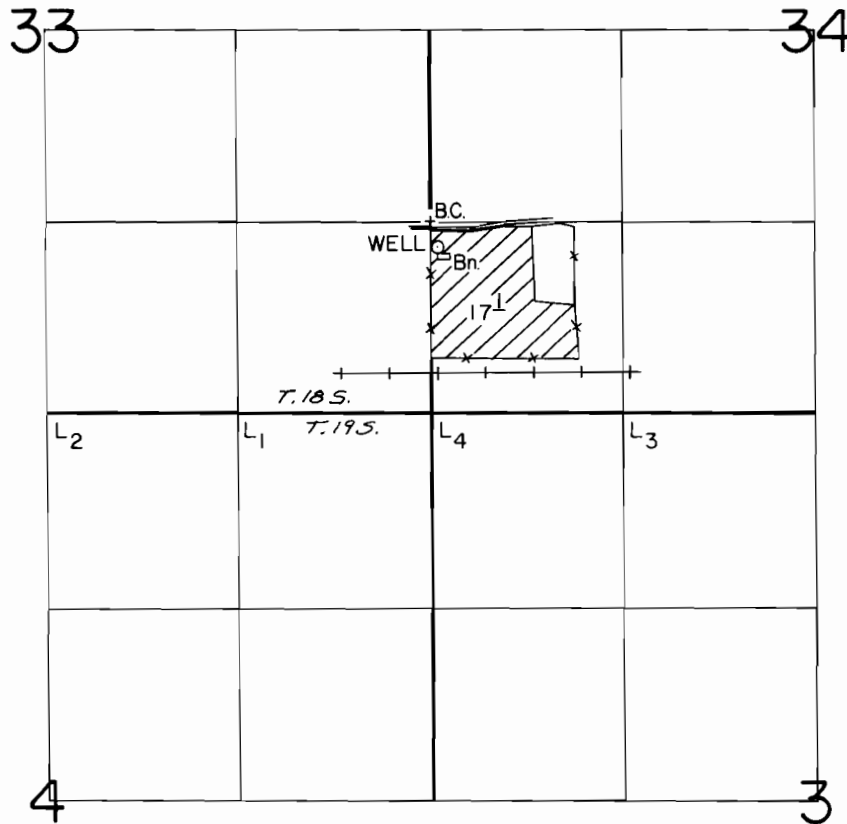

Well Loc: 170 ft. S., & 40 ft. E., from the NW corner of the SW 1/4 SW 1/4 Section 34

SCALE: 1" = 1320'

### FINAL PROOF SURVEY UNDER

Application No. G-10899 Permit No. G-10133  
IN NAME OF

LEON OR BETTY J. WHITE

Surveyed APRIL 30, 1986, by L.M. TOLL