


G-10551
36633

T. 6 N., R. 35 & 36 E., W.M.



N

Scale 1" = 1320'

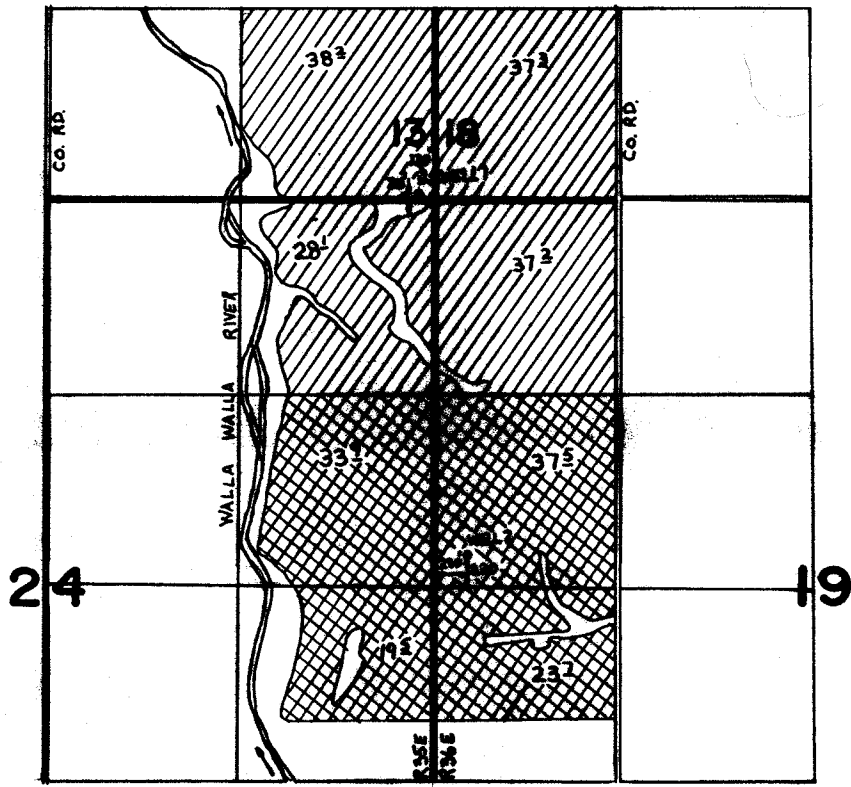

FINAL PROOF SURVEY UNDER

Application No. G11266... Permit No. G10551.....
IN NAME OF

B.P.O.E. 287 of WALLA WALLA, WA

Surveyed Nov. 24... 1986., by V. Church.....