


T.5S.,R.1E.,W.M.

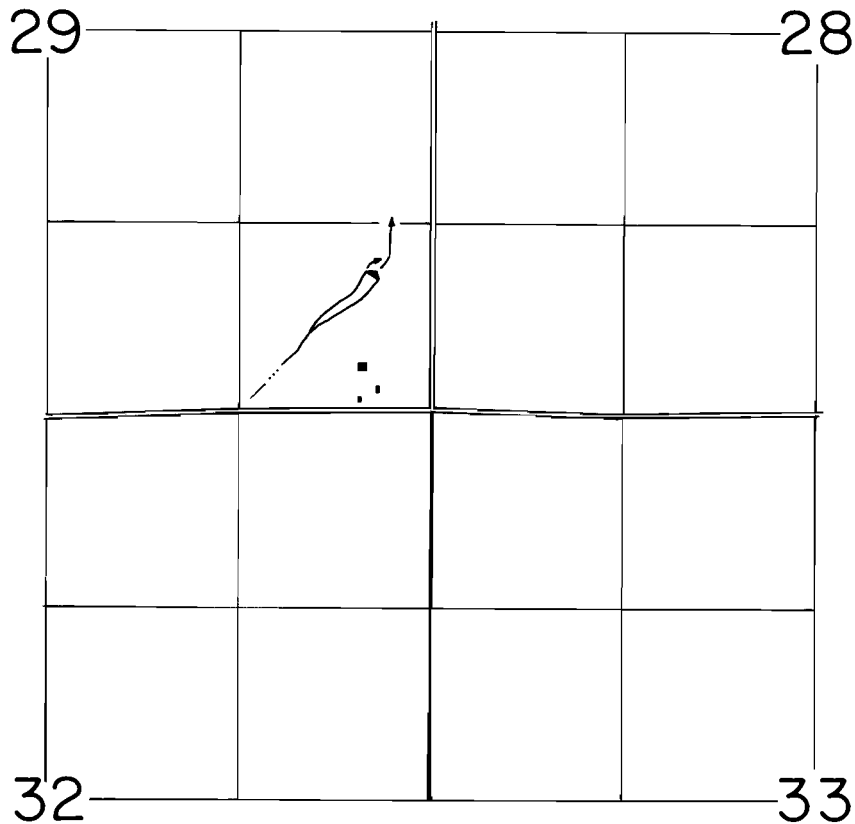

FINAL PROOF SURVEY
UNDER

Application No. R-48697 Permit No. R-5903
IN NAME OF

Clair L. Kuiper

Surveyed MAY 21, 1980, by dlb

DFQ-2LL-153