


T.10S. R.9W. W.M.

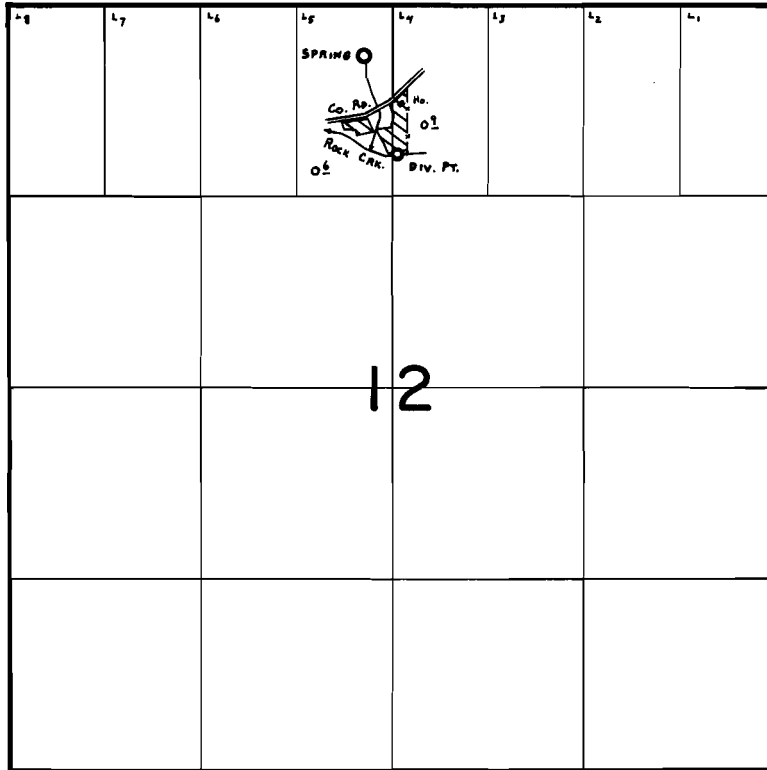

SPRING Loc: 350'S. & 200' W. } BOTH FROM N. 1/4 COR. SEC. 12.
DIV. PT. Loc: 1030'S. & 30' E. }

FINAL PROOF SURVEY
UNDER

Application No. 50417 Permit No. 37287
IN NAME OF

CHESTER HAMILTON

Surveyed June 13, 1979, by C. L. HUGHES