


T.6N.,R.10W.,W.M.

SEC. 34

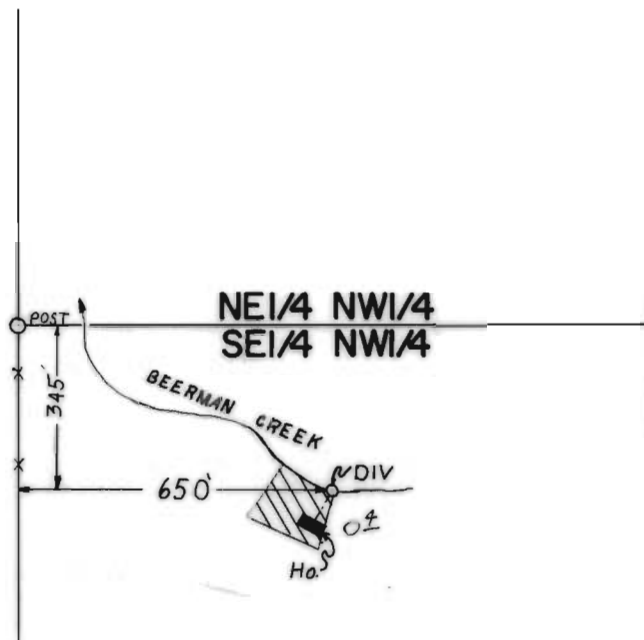

SCALE: 1" = 400'

FINAL PROOF SURVEY
UNDER

Application No. 51737 Permit No. 39128
IN NAME OF

WARREN M. KNISPEL

Surveyed SEPT. 16, 1976, by C.R. KING
FEB. 19 1980 R.G. MUGHEN