


T.18S., R.26E., W.M.

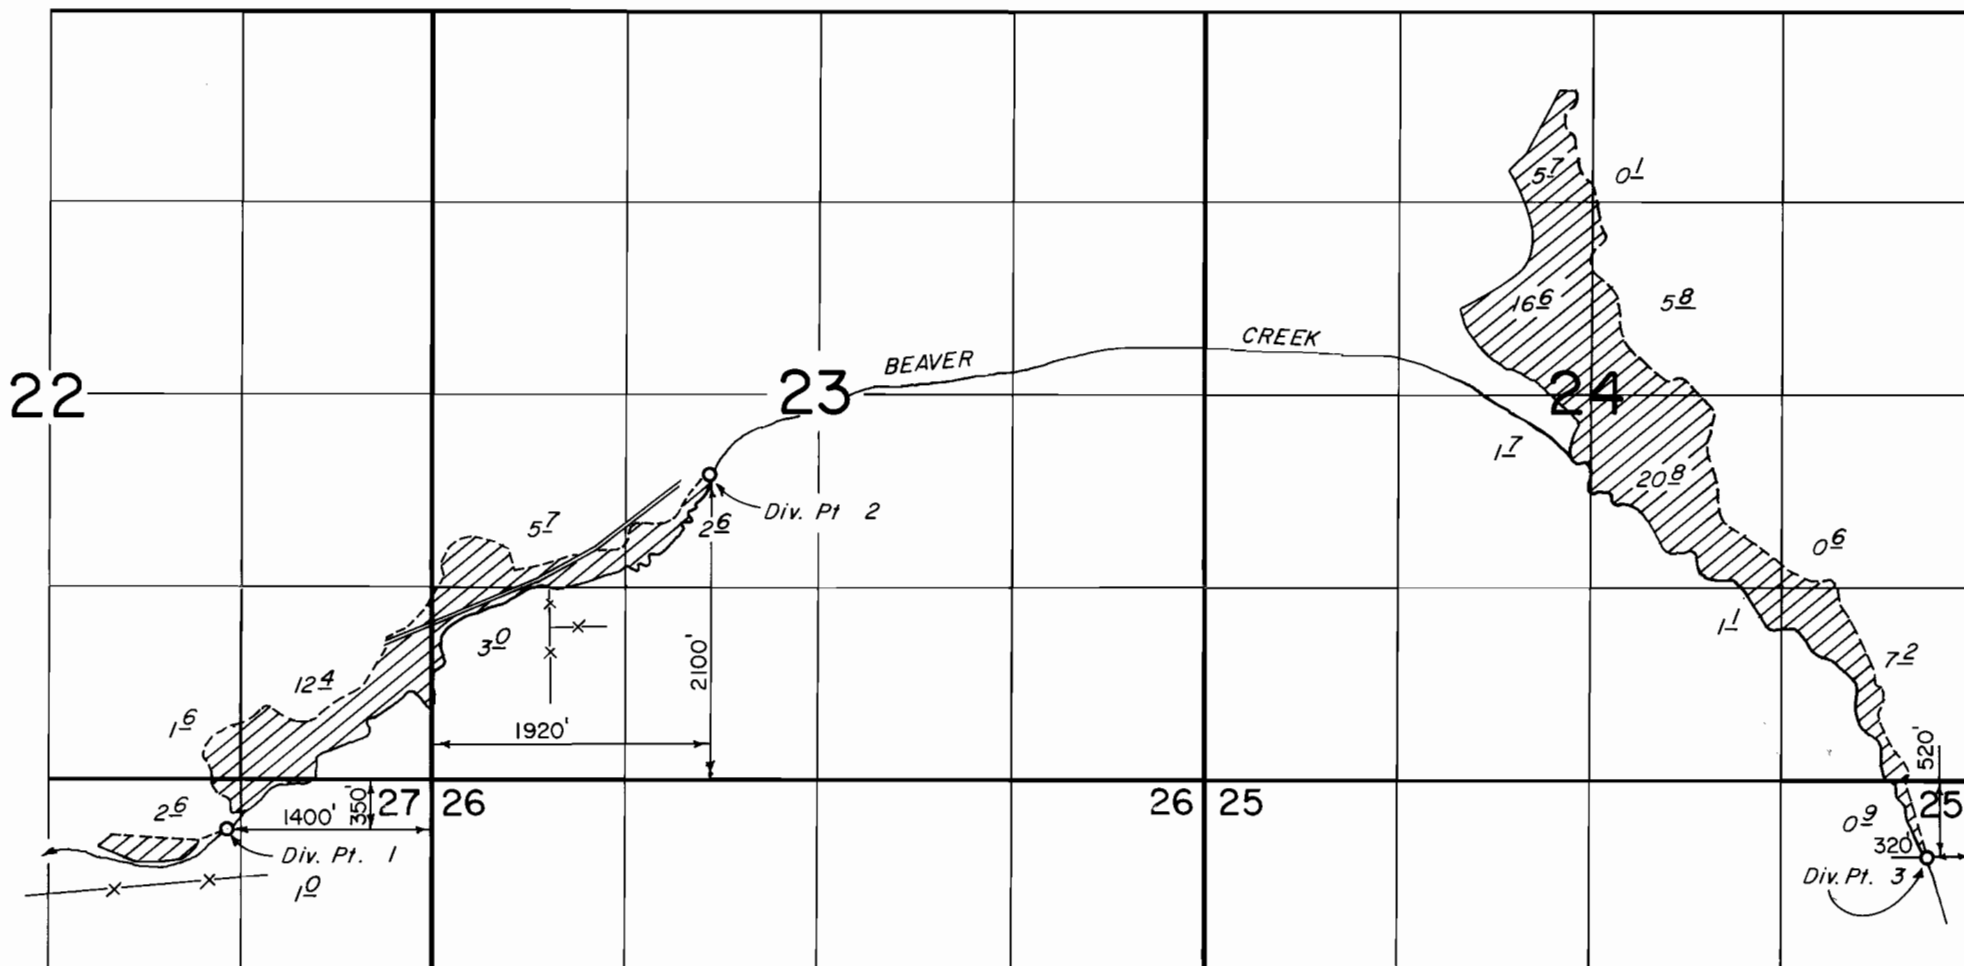

FINAL PROOF SURVEY
UNDER

Application No. 51889 Permit No. 39193
IN NAME OF

HARRIS DEMONSTRATION RANCH

Surveyed JUNE 16, 1980, by *W.B. Brown*

41023A-16762 & P15-1980-A