


T20S. R2W. W.M.

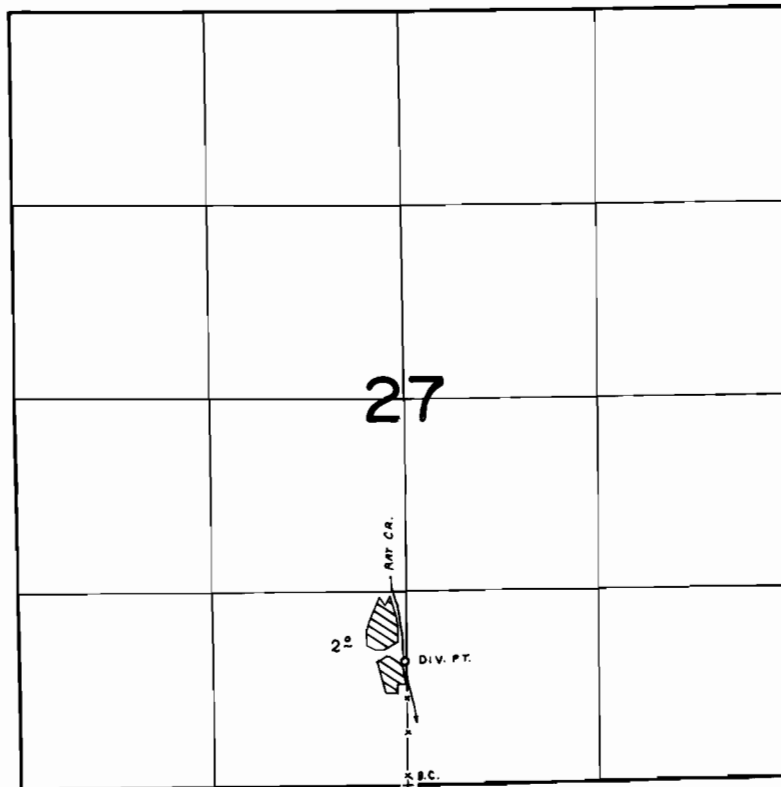

Div. Pt. Loc: 850' N. & 20' W. fr. S. $\frac{1}{4}$ Co. Sec. 27.

FINAL PROOF SURVEY
UNDER

Application No. .52063. Permit No. .39235.....
IN NAME OF

.....THOMAS LYLE IRWIN.....

Surveyed June 19, 1980, by C. L. Hughes.....